

National Grid SA-COA **PRODUCTION FILE**

Contractor : ABB Contracting Co.

Project : SS 8709- 132/13.8kV in Alkharj City

Contract No : 11131113/00

Substation : 8709

**Subject : 132Kv Busbar Protection Set-2 (+BBP2-3)
Relay Panel-3**





POWER SYSTEMS NETWORK MANAGEMENT
PROTECTION AND SUBSTATION AUTOMATION SYSTEMS
WBS NO: S-13656

ABB AUTOMATION COMPANY LTD.
414, AL-KHARJ ROAD
SECOND INDUSTRIAL CITY
RIYADH-11383 K.S.A

CONTRACTOR : ABB Contracting Company
CLIENT : National GridSA
PROJECT : CONSTRUCTION OF NEW 132/13.8kV SS 8709 IN AL-KHARJ CITY
SUBSTATION : S/S 8709
CONTRACT NO. : 11131113/00
TITLE : Assembly Drawing - +BBP2-3
[132KV BUSBAR PROTECTION MAIN-2 BAY UNIT PANEL]

AS-BUILT BY _____ DATE _____ CONTRACT NO. 11131113/00 JOB ORDER NO. S-13656

01	13 49	FACTORY ASBUILT	DRAWN BY RIZ	CHECKED BY KVR
00	13 05	FOR APPROVAL	DATE STARTED 30.01.2013	DATE COMPLETED
REV. NO.	DATE	DESCRIPTION	OPRG. DEPT. CTPD	ENG. DEPT. AUT-PSAC

COVER SHEET

132KV BUSBAR PROTN.MAIN-2 BU PANEL +BBP2-3
S/S 8709 - 132/13.8KV IN AL-KHARJ CITY
RIYADH SAUDI ARABIA


الشركة الوطنية لنقل الكهرباء



INDEX	PLANT NO.	DRAWING NUMBER	SHEET NO.	REV. NO.
-	C421	CD-323004	G00 G01	01


NG/D2-D (2012/01)

DMS VECTOR NGD200

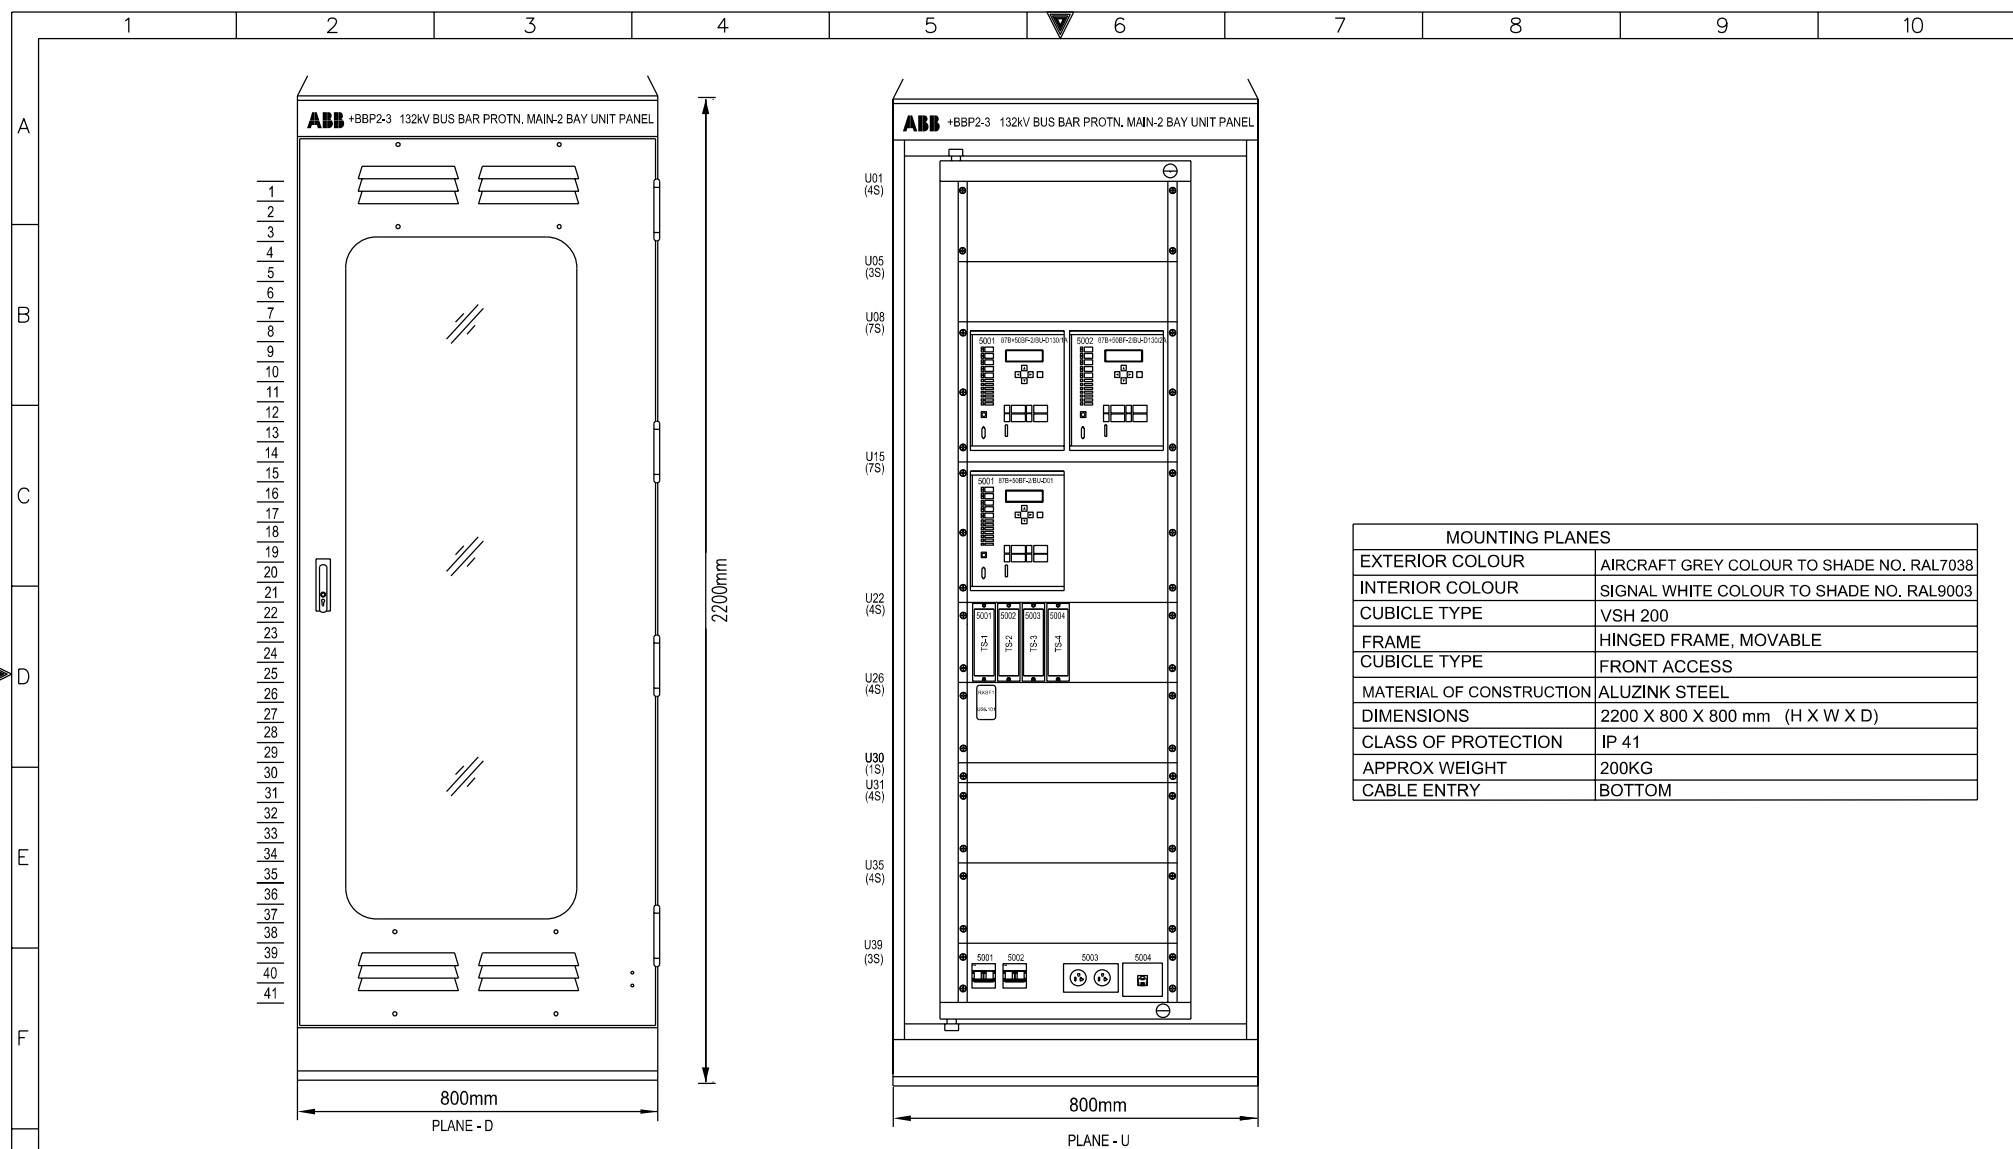


MOUNTING PLANES	
EXTERIOR COLOUR	AIRCRAFT GREY COLOUR TO SHADE NO. RAL7038
INTERIOR COLOUR	SIGNAL WHITE COLOUR TO SHADE NO. RAL9003
CUBICLE TYPE	VSH 200
FRAME	HINGED FRAME, MOVABLE
CUBICLE TYPE	FRONT ACCESS
MATERIAL OF CONSTRUCTION	ALUZINK STEEL
DIMENSIONS	2200 X 800 X 800 mm (H X W X D)
CLASS OF PROTECTION	IP 41
APPROX WEIGHT	200KG
CABLE ENTRY	BOTTOM

</

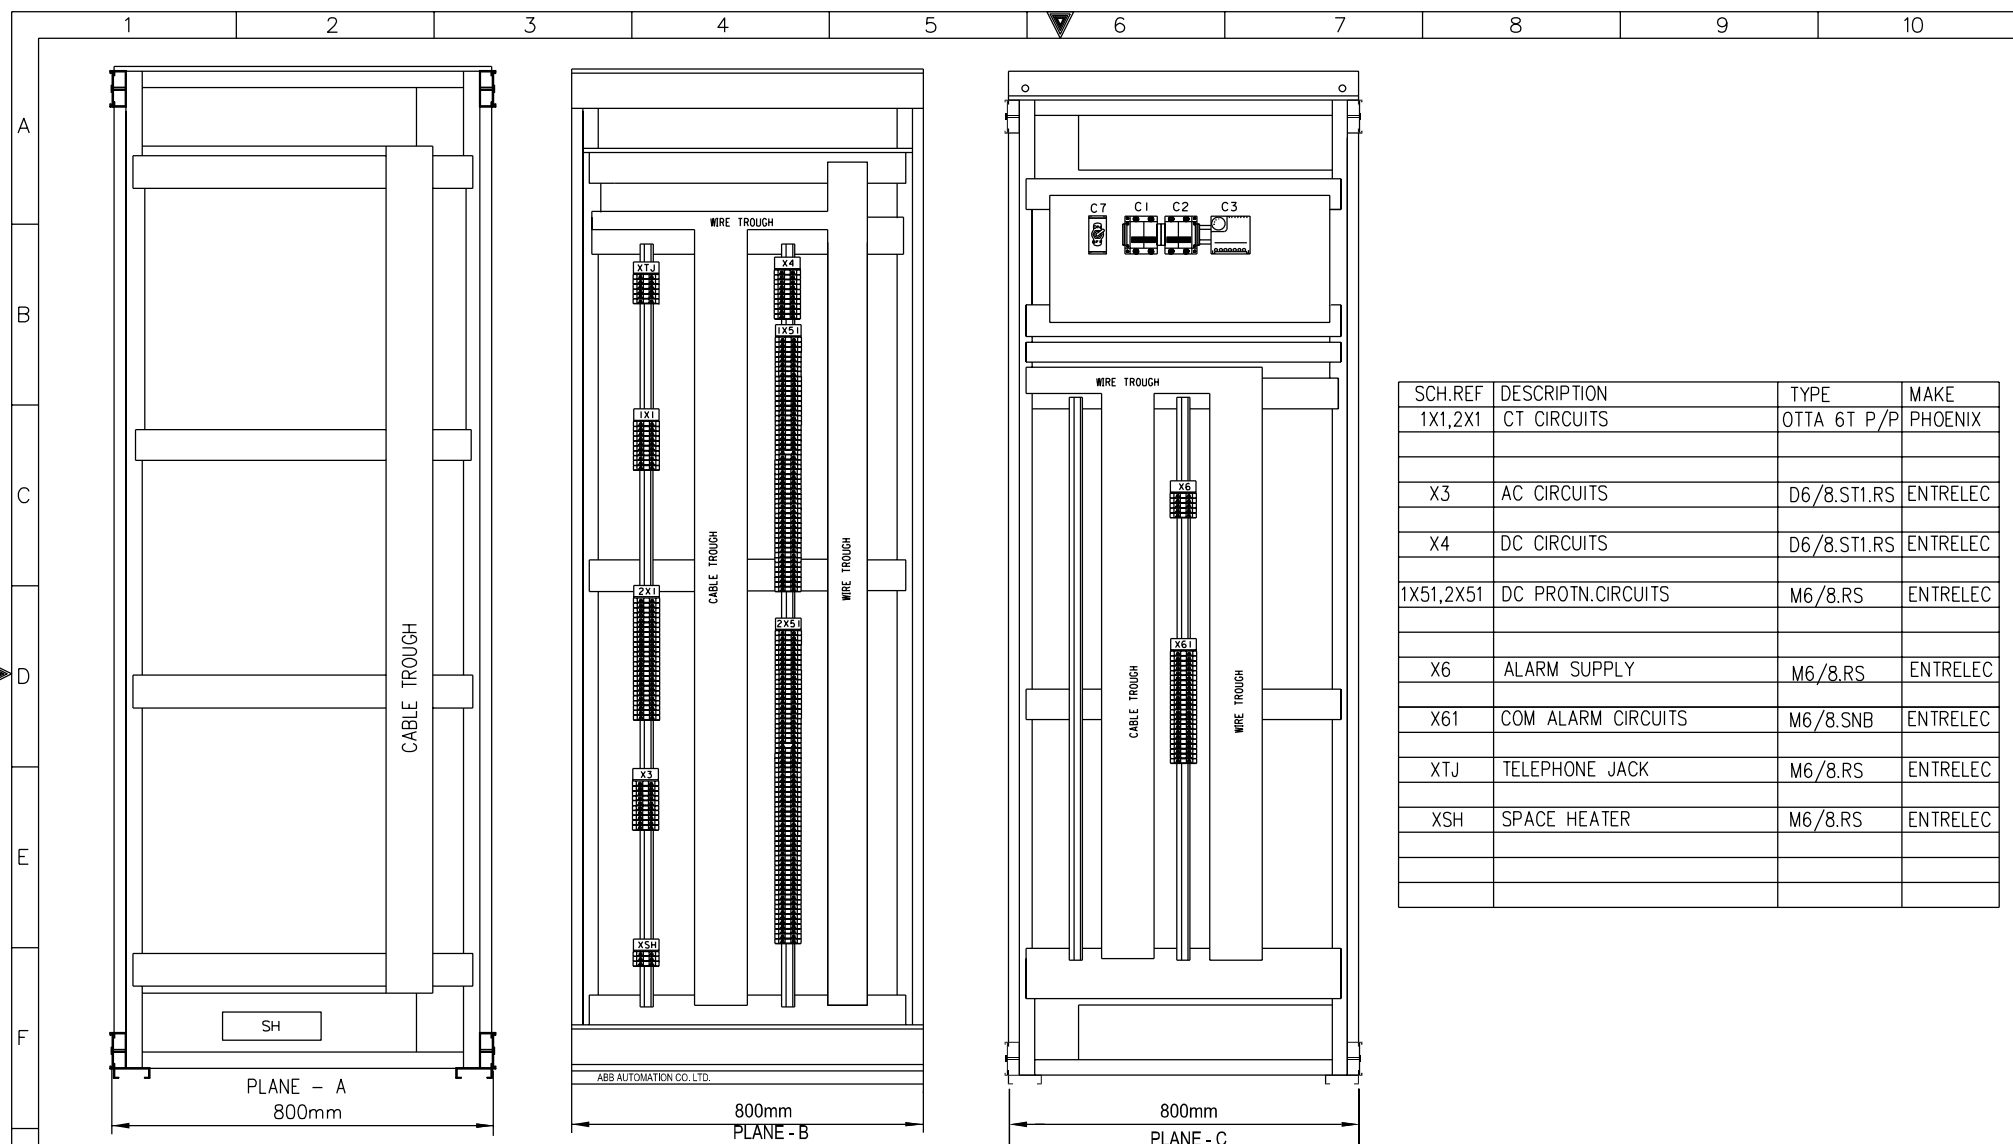

SCH.REF	DESCRIPTION	TYPE	MAKE
1X1,2X1	CT CIRCUITS	OTTA 6T P/P	PHOENIX
X3	AC CIRCUITS	D6/8.ST1.RS	ENTRELEC
X4	DC CIRCUITS	D6/8.ST1.RS	ENTRELEC
1X51,2X51	DC PROTN.CIRCUITS	M6/8.RS	ENTRELEC
X6	ALARM SUPPLY	M6/8.RS	ENTRELEC
X61	COM ALARM CIRCUITS	M6/8.SNB	ENTRELEC
XTJ	TELEPHONE JACK	M6/8.RS	ENTRELEC
XSH	SPACE HEATER	M6/8.RS	ENTRELEC

G

AS-BUILT BY _____ DATE _____			CONTRACT NO. 11131113/00		JOB ORDER NO. S-13656		ASSEMBLY DRAWING			<div>نقل الكهرباء</div> <div>الشركة الوطنية لنقل الكهرباء</div> <div>National Grid sa</div>					
01	13 49	FACTORY ASBUILT FOR APPROVAL	DRAWN BY RIZ		CHECKED BY KVR		132KV BUSBAR PROTN.MAIN-2 BU PANEL +BBP2-3			INDEX	PLANT NO.	DRAWING NUMBER		SHEET NO.	REV. NO.
00	13 05		DATE STARTED 30.01.2013		DATE COMPLETED		S/S 8709 - 132/13.8KV IN AL-KHARJ CITY			-	C421	CD-323004		SHT CONT G02 G03	01
REV. NO.	DATE	DESCRIPTION	OPRG. DEPT. CTPD		ENG. DEPT. AUT-PSAC		RIYADH SAUDI ARABIA								

	1	2	3	4	5	6	7	8	9	10
A										
B										
C										
D										
E										
F										
G										

TOP VIEW FOR EARTHING BAR

U PLANE TOP LABEL

ABB +BBP2-3 132KV BB/BF MAIN-2 PROTN. PANEL-2

800

28

U PLANE BOTTOM LABEL

ABB AUTOMATION CO. LTD

800

28

MANUFACTURING LABEL

ABB ABB Automation Co.Ltd.

PROJECT : National Grid SA
S/S 8709

ORDER REFERENCE : 2875 RF S13656

YEAR OF MANUFACTURE: 2013

PANEL NO. : +BBP2-3

DRAWING NO. : S13656-CD-323005

MADE IN THE KINGDOM OF SAUDI ARABIA

AS-BUILT BY _____ DATE _____		CONTRACT NO. 11131113/00	JOB ORDER NO. S-13656	ASSEMBLY DRAWING		الشركة الوطنية لنقل الكهرباء National Grid sa				
01	13 49	FACTORY ASBUILT	DRAWN BY RIZ CHECKED BY KVR	132KV BUSBAR PROTN.MAIN-2 BU PANEL +BBP2-3		INDEX	PLANT NO.	DRAWING NUMBER	SHEET NO.	REV. NO.
00	13 05	FOR APPROVAL	DATE STARTED 30.01.2013 DATE COMPLETED	S/S 8709 - 132/13.8KV IN AL-KHARJ CITY		-	C421	CD-323004	SHT CONT G04 L00	01
REV. NO.	DATE	DESCRIPTION	OPRG. DEPT. CTPD ENG. DEPT. AUT-PSAC	RIYADH SAUDI ARABIA						



POWER SYSTEMS NETWORK MANAGEMENT
PROTECTION AND SUBSTATION AUTOMATION SYSTEMS
WBS NO: S-13656

ABB AUTOMATION COMPANY LTD
414, AL-KHARJ ROAD
SECOND INDUSTRIAL CITY
RIYADH-11383 K.S.A

CONTRACTOR : ABB Contracting Company
CLIENT : National Gridsa
PROJECT : CONSTRUCTION OF NEW 132/13.8kV SS 8709 IN AL-KHARJ CITY
SUBSTATION : S/S 8709
CONTRACT NO. : 11131113/00
TITLE : LIST OF APPARATUS - +BBP2-3
[132KV BUSBAR PROTECTION MAIN-2 BAY UNIT PANEL]

AS-BUILT BY _____ DATE _____ CONTRACT NO. 11131113/00 JOB ORDER NO. S-13656

01	13 49	FACTORY ASBUILT	DRAWN BY RIZ	CHECKED BY KVR
00	13 05	FOR APPROVAL	DATE STARTED 30.01.2013	DATE COMPLETED
REV. NO.	DATE	DESCRIPTION	OPRG. DEPT. CTPD	ENG. DEPT. AUT-PSAC

COVER SHEET

32KV BUSBAR PROTN.MAIN-2 BU PANEL +BBP2-3
S/S 8709 - 132/13.8KV IN AL-KHARJ CITY
RIYADH SAUDI ARABIA


الشركة الوطنية لنقل الكهرباء



INDEX	PLANT NO.	DRAWING NUMBER	SHEET NO.	REV. NO.
-	C421	CD-323004	SHT 1 CONT. L00 L01	01


DMS VECTOR NGD200

	1	2	3	4	5	6	7	8	9	10	
A	SR. NO.	GA. REF.	SCH. REF.	DESCRIPTION		SHT.	QTY.	TYPE	MAKE	ORDERING INFORMATION	
	1	U08.5001	87B+50BF-2/BU-D130/1A	RELAY CUBICLE- +BBP2-3 FOR 132KV BB/BF MAIN-2 ACCOMODATING THE FOLLOWING			3	VSH 200	ABB		
		U08.5002	87B+50BF-2/BU-D130/2A	BAY UNIT FOR NUMERICAL BUSBAR PROTECTION WITH FOLLOWING		295,296		7SS523	SIEMENS	7SS5231-5CA01+1AA1	
				HIGH TROUGH-FAULT STABILITY EVEN IN CASE OF CT SATURATION.		297,298					
				NEUTRAL CURRENT CRITERION INSTANTANEOUS VALUES FOR FAULT RECORDING.							
		U15.5001	87B+50BF-2/BU-D01	DISTURBANCE FREE AND FAST DATA TRANSFER TO & FROM CENTRAL UNIT		293,294					
				PHASE SEGRAGATED MEASUREMENT							
				REDUCE CT PERFORMANCE REQUIREMENTS							
				BUILT IN HUMAN MACHINE INTERFACE							
				BUILT IN BREAKER FAILURE FUNCTION.							
B				END FAULT PROTECTION FUNCTION							
				DISTURBANCE RECORDER							
				BINARY OUTPUT : 20							
				BINARY OUTPUT : 6+2-WD							
				FULLY NUMERICAL SIGNAL PROCESSING							
				RATED CURRENT : 1A							
				AUX. VOLTAGE : 60-250V DC							
				RATED FREQUENCY : 60HZ							
C	2	U22.5001	TS-1	TEST SWITCH FOR 87B+50BF-2/BU-D01 RELAY		293	3	MMLG02	ALSTOM	MMLG02 R1AA 0001D	
		U22.5002	TS-2	TEST SWITCH FOR 87B+50BF-2/BU-D130/1A RELAY		295					
		U22.5003	TS-3	TEST SWITCH FOR 87B+50BF-2/BU-D130/2A RELAY		297					
	3	U26.101	74BF-2/BU-D01	DUAL TARGET RELAY FOR 87B+50BF-2/D01AND 87B+50BF-2/D130 DC SUPERVISION		232	1	RXSF 1	ABB	RK 271 019-AN	
			/74BF-2/BU-D130	AUXILIARY VOLTAGE : 110-125V DC		237					
				CONTACT DATA : 1NO + 2NC							
				FLAG : SELF RESET,REVERSE							
D											
E											
F											
G	AS-BUILT BY _____ DATE _____		CONTRACT NO. 11131113/00		JOB ORDER NO. S-13656		LIST OF APPARATUS				
	01	13 49	FACTORY ASBUILT		DRAWN BY RIZ CHECKED BY KVR		132KV BUSBAR PROTN.MAIN-2 BU PANEL +BBP2-3				
	00	13 05	FOR APPROVAL		DATE STARTED 30.01.2013 DATE COMPLETED _____		S/S 8709 - 132/13.8KV IN AL-KHARJ CITY				
	REV. NO.	DATE	DESCRIPTION		OPRG. DEPT. CTPD ENG. DEPT. AUT-PSAC		RIYADH SAUDI ARABIA				
							INDEX	PLANT NO.	DRAWING NUMBER	SHEET NO.	REV. NO.
							-	C421	CD-323004	L01 L02	01


نقل الكهرباء
 الشركة الوطنية لنقل الكهرباء
 National Grid SA

NG/D2-D (2012/01)
 VECTOR NGD200

	1	2	3	4	5	6	7	8	9	10
A										
B										
C										
D										
E										
F										
G										

AS-BUILT BY _____ DATE _____		CONTRACT NO. 11131113/00		JOB ORDER NO. S-13656		LIST OF APPARATUS		<div>الشركة الوطنية لنقل الكهرباء</div> <div> نقل الكهرباء National Grid sa</div>				
01	13 49	FACTORY ASBUILT		DRAWN BY RIZ CHECKED BY KVR		132KV BUSBAR PROTN.MAIN-2 BU PANEL +BBP2-3		INDEX	PLANT NO.	DRAWING NUMBER	SHEET NO.	REV. NO.
00	13 05	FOR APPROVAL		DATE STARTED 30.01.2013 DATE COMPLETED _____		S/S 8709 - 132/13.8KV IN AL-KHARJ CITY					SHT CONT	
REV. NO.	DATE	DESCRIPTION		OPRG. DEPT. CTPD ENG. DEPT. AUT-PSAC		RIYADH SAUDI ARABIA		-	C421	CD-323004	L04 L05	01

THIS DRAWING AND THE INFORMATION CONTAINED HEREIN ARE THE SOLE PROPERTY OF NATIONAL GRID SA. NO REPRODUCTION IN FULL OR IN PART SHALL BE OBTAINED FROM THIS DOCUMENT WITHOUT THE WRITTEN CONSENT OF ITS OWNER.


	1	2	3	4	5	6	7	8	9	10																																																									
A																																																																			
B																																																																			
C																																																																			
D																																																																			
E																																																																			
F																																																																			
G	<table><tr><td colspan="3">AS-BUILT BY _____ DATE _____</td><td colspan="2">CONTRACT NO. 11131113/00</td><td colspan="2">JOB ORDER NO. S-13656</td><td colspan="3">LIST OF APPARATUS</td><td colspan="2"><div>الشركة الوطنية لنقل الكهرباء</div><div> نقل الكهرباء National Grid sa</div></td></tr><tr><td>01</td><td>13 49</td><td colspan="3">FACTORY ASBUILT</td><td colspan="2">DRAWN BY RIZ CHECKED BY KVR</td><td colspan="3">132KV BUSBAR PROTN.MAIN-2 BU PANEL +BBP2-3</td><td>INDEX</td><td>PLANT NO.</td><td>DRAWING NUMBER</td><td>SHEET NO.</td><td>REV. NO.</td></tr><tr><td>00</td><td>13 05</td><td colspan="3">FOR APPROVAL</td><td colspan="2">DATE STARTED 30.01.2013 DATE COMPLETED _____</td><td colspan="3">S/S 8709 - 132/13.8KV IN AL-KHARJ CITY</td><td></td><td></td><td></td><td>SHT CONT.</td><td></td></tr><tr><td>REV. NO.</td><td>DATE</td><td colspan="3">DESCRIPTION</td><td colspan="2">OPRG. DEPT. CTPD ENG. DEPT. AUT-PSAC</td><td colspan="3">RIYADH SAUDI ARABIA</td><td>-</td><td>C421</td><td>CD-323004</td><td>L05 NIL</td><td>01</td></tr></table>										AS-BUILT BY _____ DATE _____			CONTRACT NO. 11131113/00		JOB ORDER NO. S-13656		LIST OF APPARATUS			<div>الشركة الوطنية لنقل الكهرباء</div> <div> نقل الكهرباء National Grid sa</div>		01	13 49	FACTORY ASBUILT			DRAWN BY RIZ CHECKED BY KVR		132KV BUSBAR PROTN.MAIN-2 BU PANEL +BBP2-3			INDEX	PLANT NO.	DRAWING NUMBER	SHEET NO.	REV. NO.	00	13 05	FOR APPROVAL			DATE STARTED 30.01.2013 DATE COMPLETED _____		S/S 8709 - 132/13.8KV IN AL-KHARJ CITY						SHT CONT.		REV. NO.	DATE	DESCRIPTION			OPRG. DEPT. CTPD ENG. DEPT. AUT-PSAC		RIYADH SAUDI ARABIA			-	C421	CD-323004	L05 NIL	01
AS-BUILT BY _____ DATE _____			CONTRACT NO. 11131113/00		JOB ORDER NO. S-13656		LIST OF APPARATUS			<div>الشركة الوطنية لنقل الكهرباء</div> <div> نقل الكهرباء National Grid sa</div>																																																									
01	13 49	FACTORY ASBUILT			DRAWN BY RIZ CHECKED BY KVR		132KV BUSBAR PROTN.MAIN-2 BU PANEL +BBP2-3			INDEX	PLANT NO.	DRAWING NUMBER	SHEET NO.	REV. NO.																																																					
00	13 05	FOR APPROVAL			DATE STARTED 30.01.2013 DATE COMPLETED _____		S/S 8709 - 132/13.8KV IN AL-KHARJ CITY						SHT CONT.																																																						
REV. NO.	DATE	DESCRIPTION			OPRG. DEPT. CTPD ENG. DEPT. AUT-PSAC		RIYADH SAUDI ARABIA			-	C421	CD-323004	L05 NIL	01																																																					



POWER SYSTEMS NETWORK MANAGEMENT
PROTECTION AND SUBSTATION AUTOMATION SYSTEMS
WBS NO: S-13656

ABB AUTOMATION COMPANY LTD.
414, AL-KHARJ ROAD
SECOND INDUSTRIAL CITY
RIYADH-11383 K.S.A

CONTRACTOR : ABB Contracting Company
CLIENT : National GridsA
PROJECT : CONSTRUCTION OF NEW 132/13.8kv SS 8709 IN AL-KHARJ CITY
SUBSTATION : S/S 8709
CONTRACT NO. : 11131113/00
TITLE : SCHEMATICS DRAWINGS - +BBP2-3
[132KV BUSBAR PROTECTION MAIN-2 BAY UNIT PANEL]

AS-BUILT BY _____ DATE _____			CONTRACT NO. 11131113/00		JOB ORDER NO. S-13656		COVER SHEET			<div>نقل الكهرباء</div> <div>الشركة الوطنية لنقل الكهرباء</div> <div>National Grid SA</div>											
01		13 49		FACTORY ASBUILT		DRAWN BY RIZ		CHECKED BY KVR		132KV BUSBAR PROTN.MAIN-2 BU PANEL +BBP2-3											
00		13 05		FOR APPROVAL		DATE STARTED 30.01.2013		DATE COMPLETED _____		S/S 8709 - 132/13.8KV IN AL-KHARJ CITY											
REV. NO.		DATE		DESCRIPTION		OPRG. DEPT. CTPD		ENG. DEPT. AUT-PSAC		RIYADH		SAUDI ARABIA		INDEX	PLANT NO.	DRAWING NUMBER		SHEET NO.		REV. NO.	
														-	C421	CD-323005		SHT CONT.		01	
																		000		001	

	1	2	3	4	5	6	7	8	9	10																																																																																																																																																																																																																																																																																																																																																																																																																																																																																																																																																																																																																																																																																		
A	<table><thead><tr><th>CONTENTS</th><th>ABB SHT.NO.</th><th>REV.00</th><th>REV.01</th><th>REV.02</th></tr></thead><tbody><tr><td>COVER SHEET</td><td>000</td><td>X</td><td>X</td><td></td></tr><tr><td>CONTENTS SHEET</td><td>001</td><td>X</td><td>X</td><td></td></tr><tr><td>GRAPHICAL SYMBOLS FOR DIAGRAMS</td><td>011</td><td>X</td><td>X</td><td></td></tr><tr><td>GRAPHICAL SYMBOLS FOR DIAGRAMS</td><td>012</td><td>X</td><td>X</td><td></td></tr><tr><td>COMMON LEGEND</td><td>013</td><td>X</td><td>X</td><td></td></tr><tr><td>FERRULE AND WIRING DETAILS</td><td>014</td><td>X</td><td>X</td><td></td></tr><tr><td>DRAWING REFERENCES</td><td>015</td><td>X</td><td>X</td><td></td></tr><tr><td>DRAWING REFERENCES</td><td>016</td><td>X</td><td>X</td><td></td></tr><tr><td>PRIMARY SYSTEM</td><td>051-053</td><td>X</td><td>X</td><td></td></tr><tr><td>AC SUPPLY FOR ILLUMINATION & POWER SOCKET</td><td>211</td><td>X</td><td>X</td><td></td></tr><tr><td>CUB. LIGHTING, HEATER & SOCKET ALARM CKT.</td><td>212</td><td>X</td><td>X</td><td></td></tr><tr><td>DC SUPPLY DISTRIBUTION</td><td>216</td><td>X</td><td>X</td><td></td></tr><tr><td>CURRENT TRANSFORMER INPUTS -87B+50BF-2/BU-D01</td><td>221</td><td>X</td><td>X</td><td></td></tr><tr><td>CURRENT TRANSFORMER INPUTS -87B+50BF-2/BU-D130/1A</td><td>222</td><td>X</td><td>X</td><td></td></tr><tr><td>CURRENT TRANSFORMER INPUTS -87B+50BF-2/BU-D130/2A</td><td>223</td><td>X</td><td>X</td><td></td></tr><tr><td>87B+50BF-2/BU-D01 PROTN.RELAY-BINARY INPUTS</td><td>231</td><td>X</td><td>X</td><td></td></tr><tr><td>87B+50BF-2/BU-D01PROTN.RELAY-BINARY INPUTS</td><td>232</td><td>X</td><td>X</td><td></td></tr><tr><td>CBF & BUSBAR PROTN-2 TRIP RELAY CIRCUIT -D01</td><td>233</td><td>X</td><td>X</td><td></td></tr><tr><td>87B+50BF-2/BU-D130/1A PROTN.RELAY-BINARY INPUTS</td><td>234</td><td>X</td><td>X</td><td></td></tr><tr><td>87B+50BF-2/BU-D130/1A PROTN.RELAY-BINARY INPUTS</td><td>235</td><td>X</td><td>X</td><td></td></tr><tr><td>87B+50BF-2/BU-D130/2A PROTN.RELAY-BINARY INPUTS</td><td>236</td><td>X</td><td>X</td><td></td></tr><tr><td>87B+50BF-2/BU-D130/2A PROTN.RELAY-BINARY INPUTS</td><td>237</td><td>X</td><td>X</td><td></td></tr><tr><td>CBF & BUSBAR PROTN-2 TRIP RELAY CIRCUIT -D130</td><td>238</td><td>X</td><td>X</td><td></td></tr><tr><td></td><td></td><td></td><td></td><td></td></tr><tr><td></td><td></td><td></td><td></td><td></td></tr><tr><td></td><td></td><td></td><td></td><td></td></tr><tr><td>B</td><td colspan="5" rowspan="20"><table><thead><tr><th>CONTENTS</th><th>ABB SHT.NO.</th><th>REV.00</th><th>REV.01</th><th>REV.02</th></tr></thead><tbody><tr><td>COMMON ALARM CIRCUITS</td><td>292</td><td>X</td><td>X</td><td></td></tr><tr><td>BLOCK REFERENCE 87B+50BF-2/BU-D01</td><td>293</td><td>X</td><td>X</td><td></td></tr><tr><td>BLOCK REFERENCE 87B+50BF-2/BU-D01</td><td>294</td><td>X</td><td>X</td><td></td></tr><tr><td>BLOCK REFERENCE 87B+50BF-2/BU-D130/1A</td><td>295</td><td>X</td><td>X</td><td></td></tr><tr><td>BLOCK REFERENCE 87B+50BF-2/BU-D130/1A</td><td>296</td><td>X</td><td>X</td><td></td></tr><tr><td>BLOCK REFERENCE 87B+50BF-2/BU-D130/2A</td><td>297</td><td>X</td><td>X</td><td></td></tr><tr><td>BLOCK REFERENCE 87B+50BF-2/BU-D130/2A</td><td>298</td><td>X</td><td>X</td><td></td></tr><tr><td>TERMINAL BLOCKS REFERENCE</td><td>301</td><td>X</td><td>X</td><td></td></tr><tr><td></td><td></td><td></td><td></td><td></td></tr><tr><td></td><td></td><td></td><td></td><td></td></tr><tr><td></td><tcolspan="5"></td></tr><tr><td colspan="5"></td></tr><tr><td colspan="5"></td></tr><tr><td colspan="5"></td></tr><tr><td colspan="5"></td></tr><tr><td>G</td><td colspan="5"><table><tr><td colspan="2">AS-BUILT BY _____ DATE _____</td><td colspan="2">CONTRACT NO. 11131113/00</td><td colspan="2">JOB ORDER NO. S-13656</td></tr><tr><td colspan="2">01 13 49</td><td colspan="2">FACTORY ASBUILT</td><td colspan="2">DRAWN BY RIZ CHECKED BY KVR</td></tr><tr><td colspan="2">00 13 05</td><td colspan="2">FOR APPROVAL</td><td colspan="2">DATE STARTED 30.01.2013 DATE COMPLETED _____</td></tr><tr><td colspan="2">REV. NO.</td><td colspan="2">DATE</td><td colspan="2">DESCRIPTION</td></tr><tr><td colspan="2"></td><td colspan="2"></td><td colspan="2">OPRG. DEPT. CTPD ENG. DEPT. AUT-PSAC</td></tr></table></td></tr><tr><td colspan="5"><table><tr><td colspan="2">CONTENTS SHEET</td></tr><tr><td colspan="2">32KV BUSBAR PROTN.MAIN-2 BU PANEL +BBP2-3</td></tr><tr><td colspan="2">S/S 8709 - 132/13.8KV IN AL-KHARJ CITY</td></tr><tr><td colspan="2">RIYADH SAUDI ARABIA</td></tr></table></td></tr><tr><td colspan="5"><table><tr><td colspan="2">الشركة الوطنية لنقل الكهرباء</td><td colspan="2">National Grid sa</td></tr><tr><td>INDEX</td><td>PLANT NO.</td><td>DRAWING NUMBER</td><td>SHEET NO.</td><td>REV. NO.</td></tr><tr><td>-</td><td>C421</td><td>CD-323005</td><td>001 011</td><td>01</td></tr></table></td></tr><tr><td colspan="5">NG/D2-D (2012/01)</td></tr><tr><td colspan="5">DMS VECTOR NGD200</td></tr></tbody></table></td></tr></tbody></table>					CONTENTS	ABB SHT.NO.	REV.00	REV.01	REV.02	COVER SHEET	000	X	X		CONTENTS SHEET	001	X	X		GRAPHICAL SYMBOLS FOR DIAGRAMS	011	X	X		GRAPHICAL SYMBOLS FOR DIAGRAMS	012	X	X		COMMON LEGEND	013	X	X		FERRULE AND WIRING DETAILS	014	X	X		DRAWING REFERENCES	015	X	X		DRAWING REFERENCES	016	X	X		PRIMARY SYSTEM	051-053	X	X		AC SUPPLY FOR ILLUMINATION & POWER SOCKET	211	X	X		CUB. LIGHTING, HEATER & SOCKET ALARM CKT.	212	X	X		DC SUPPLY DISTRIBUTION	216	X	X		CURRENT TRANSFORMER INPUTS -87B+50BF-2/BU-D01	221	X	X		CURRENT TRANSFORMER INPUTS -87B+50BF-2/BU-D130/1A	222	X	X		CURRENT TRANSFORMER INPUTS -87B+50BF-2/BU-D130/2A	223	X	X		87B+50BF-2/BU-D01 PROTN.RELAY-BINARY INPUTS	231	X	X		87B+50BF-2/BU-D01PROTN.RELAY-BINARY INPUTS	232	X	X		CBF & BUSBAR PROTN-2 TRIP RELAY CIRCUIT -D01	233	X	X		87B+50BF-2/BU-D130/1A PROTN.RELAY-BINARY INPUTS	234	X	X		87B+50BF-2/BU-D130/1A PROTN.RELAY-BINARY INPUTS	235	X	X		87B+50BF-2/BU-D130/2A PROTN.RELAY-BINARY INPUTS	236	X	X		87B+50BF-2/BU-D130/2A PROTN.RELAY-BINARY INPUTS	237	X	X		CBF & BUSBAR PROTN-2 TRIP RELAY CIRCUIT -D130	238	X	X																	B	<table><thead><tr><th>CONTENTS</th><th>ABB SHT.NO.</th><th>REV.00</th><th>REV.01</th><th>REV.02</th></tr></thead><tbody><tr><td>COMMON ALARM CIRCUITS</td><td>292</td><td>X</td><td>X</td><td></td></tr><tr><td>BLOCK REFERENCE 87B+50BF-2/BU-D01</td><td>293</td><td>X</td><td>X</td><td></td></tr><tr><td>BLOCK REFERENCE 87B+50BF-2/BU-D01</td><td>294</td><td>X</td><td>X</td><td></td></tr><tr><td>BLOCK REFERENCE 87B+50BF-2/BU-D130/1A</td><td>295</td><td>X</td><td>X</td><td></td></tr><tr><td>BLOCK REFERENCE 87B+50BF-2/BU-D130/1A</td><td>296</td><td>X</td><td>X</td><td></td></tr><tr><td>BLOCK REFERENCE 87B+50BF-2/BU-D130/2A</td><td>297</td><td>X</td><td>X</td><td></td></tr><tr><td>BLOCK REFERENCE 87B+50BF-2/BU-D130/2A</td><td>298</td><td>X</td><td>X</td><td></td></tr><tr><td>TERMINAL BLOCKS REFERENCE</td><td>301</td><td>X</td><td>X</td><td></td></tr><tr><td></td><td></td><td></td><td></td><td></td></tr><tr><td></td><td></td><td></td><td></td><td></td></tr><tr><td></td><td></td><td></td><td></td><td></td></tr><tr><td></td><td></td><td></td><td></td><td></td></tr><tr><td></td><td></td><td></td><td></td><td></td></tr><tr><td></td><td></td><td></td><td></td><td></td></tr><tr><td></td><td></td><td></td><td></td><td></td></tr><tr><td></td><td></td><td></td><td></td><td></td></tr><tr><td></td><td></td><td></td><td></td><td></td></tr><tr><td></td><td></td><td></td><td></td><td></td></tr><tr><td>C</td><td colspan="5" rowspan="20"></td></tr><tr><td 05</td><td colspan="2">FOR APPROVAL</td><td colspan="2">DATE STARTED 30.01.2013 DATE COMPLETED _____</td></tr><tr><td colspan="2">REV. NO.</td><td colspan="2">DATE</td><td colspan="2">DESCRIPTION</td></tr><tr><td colspan="2"></td><td colspan="2"></td><td colspan="2">OPRG. DEPT. CTPD ENG. DEPT. AUT-PSAC</td></tr></table></td></tr><tr><td colspan="5"><table><tr><td colspan="2">CONTENTS SHEET</td></tr><tr><td colspan="2">32KV BUSBAR PROTN.MAIN-2 BU PANEL +BBP2-3</td></tr><tr><td colspan="2">S/S 8709 - 132/13.8KV IN AL-KHARJ CITY</td></tr><tr><td colspan="2">RIYADH SAUDI ARABIA</td></tr></table></td></tr><tr><td colspan="5"><table><tr><td colspan="2">الشركة الوطنية لنقل الكهرباء</td><td colspan="2">National Grid sa</td></tr><tr><td>INDEX</td><td>PLANT NO.</td><td>DRAWING NUMBER</td><td>SHEET NO.</td><td>REV. NO.</td></tr><tr><td>-</td><td>C421</td><td>CD-323005</td><td>001 011</td><td>01</td></tr></table></td></tr><tr><td colspan="5">NG/D2-D (2012/01)</td></tr><tr><td colspan="5">DMS VECTOR NGD200</td></tr></tbody></table>					CONTENTS	ABB SHT.NO.	REV.00	REV.01	REV.02	COMMON ALARM CIRCUITS	292	X	X		BLOCK REFERENCE 87B+50BF-2/BU-D01	293	X	X		BLOCK REFERENCE 87B+50BF-2/BU-D01	294	X	X		BLOCK REFERENCE 87B+50BF-2/BU-D130/1A	295	X	X		BLOCK REFERENCE 87B+50BF-2/BU-D130/1A	296	X	X		BLOCK REFERENCE 87B+50BF-2/BU-D130/2A	297	X	X		BLOCK REFERENCE 87B+50BF-2/BU-D130/2A	298	X	X		TERMINAL BLOCKS REFERENCE	301	X	X																																																				C																																																																																											D																																																																																						E																																																																																						F																																																																																						G	<table><tr><td colspan="2">AS-BUILT BY _____ DATE _____</td><td colspan="2">CONTRACT NO. 11131113/00</td><td colspan="2">JOB ORDER NO. S-13656</td></tr><tr><td colspan="2">01 13 49</td><td colspan="2">FACTORY ASBUILT</td><td colspan="2">DRAWN BY RIZ CHECKED BY KVR</td></tr><tr><td colspan="2">00 13 05</td><td colspan="2">FOR APPROVAL</td><td colspan="2">DATE STARTED 30.01.2013 DATE COMPLETED _____</td></tr><tr><td colspan="2">REV. NO.</td><td colspan="2">DATE</td><td colspan="2">DESCRIPTION</td></tr><tr><td colspan="2"></td><td colspan="2"></td><td colspan="2">OPRG. DEPT. CTPD ENG. DEPT. AUT-PSAC</td></tr></table>					AS-BUILT BY _____ DATE _____		CONTRACT NO. 11131113/00		JOB ORDER NO. S-13656		01 13 49		FACTORY ASBUILT		DRAWN BY RIZ CHECKED BY KVR		00 13 05		FOR APPROVAL		DATE STARTED 30.01.2013 DATE COMPLETED _____		REV. NO.		DATE		DESCRIPTION						OPRG. DEPT. CTPD ENG. DEPT. AUT-PSAC		<table><tr><td colspan="2">CONTENTS SHEET</td></tr><tr><td colspan="2">32KV BUSBAR PROTN.MAIN-2 BU PANEL +BBP2-3</td></tr><tr><td colspan="2">S/S 8709 - 132/13.8KV IN AL-KHARJ CITY</td></tr><tr><td colspan="2">RIYADH SAUDI ARABIA</td></tr></table>					CONTENTS SHEET		32KV BUSBAR PROTN.MAIN-2 BU PANEL +BBP2-3		S/S 8709 - 132/13.8KV IN AL-KHARJ CITY		RIYADH SAUDI ARABIA		<table><tr><td colspan="2">الشركة الوطنية لنقل الكهرباء</td><td colspan="2">National Grid sa</td></tr><tr><td>INDEX</td><td>PLANT NO.</td><td>DRAWING NUMBER</td><td>SHEET NO.</td><td>REV. NO.</td></tr><tr><td>-</td><td>C421</td><td>CD-323005</td><td>001 011</td><td>01</td></tr></table>					الشركة الوطنية لنقل الكهرباء		National Grid sa		INDEX	PLANT NO.	DRAWING NUMBER	SHEET NO.	REV. NO.	-	C421	CD-323005	001 011	01	NG/D2-D (2012/01)					DMS VECTOR NGD200				
CONTENTS						ABB SHT.NO.	REV.00	REV.01	REV.02																																																																																																																																																																																																																																																																																																																																																																																																																																																																																																																																																																																																																																																																																			
COVER SHEET						000	X	X																																																																																																																																																																																																																																																																																																																																																																																																																																																																																																																																																																																																																																																																																				
CONTENTS SHEET						001	X	X																																																																																																																																																																																																																																																																																																																																																																																																																																																																																																																																																																																																																																																																																				
GRAPHICAL SYMBOLS FOR DIAGRAMS						011	X	X																																																																																																																																																																																																																																																																																																																																																																																																																																																																																																																																																																																																																																																																																				
GRAPHICAL SYMBOLS FOR DIAGRAMS						012	X	X																																																																																																																																																																																																																																																																																																																																																																																																																																																																																																																																																																																																																																																																																				
COMMON LEGEND						013	X	X																																																																																																																																																																																																																																																																																																																																																																																																																																																																																																																																																																																																																																																																																				
FERRULE AND WIRING DETAILS						014	X	X																																																																																																																																																																																																																																																																																																																																																																																																																																																																																																																																																																																																																																																																																				
DRAWING REFERENCES						015	X	X																																																																																																																																																																																																																																																																																																																																																																																																																																																																																																																																																																																																																																																																																				
DRAWING REFERENCES						016	X	X																																																																																																																																																																																																																																																																																																																																																																																																																																																																																																																																																																																																																																																																																				
PRIMARY SYSTEM						051-053	X	X																																																																																																																																																																																																																																																																																																																																																																																																																																																																																																																																																																																																																																																																																				
AC SUPPLY FOR ILLUMINATION & POWER SOCKET						211	X	X																																																																																																																																																																																																																																																																																																																																																																																																																																																																																																																																																																																																																																																																																				
CUB. LIGHTING, HEATER & SOCKET ALARM CKT.						212	X	X																																																																																																																																																																																																																																																																																																																																																																																																																																																																																																																																																																																																																																																																																				
DC SUPPLY DISTRIBUTION						216	X	X																																																																																																																																																																																																																																																																																																																																																																																																																																																																																																																																																																																																																																																																																				
CURRENT TRANSFORMER INPUTS -87B+50BF-2/BU-D01						221	X	X																																																																																																																																																																																																																																																																																																																																																																																																																																																																																																																																																																																																																																																																																				
CURRENT TRANSFORMER INPUTS -87B+50BF-2/BU-D130/1A						222	X	X																																																																																																																																																																																																																																																																																																																																																																																																																																																																																																																																																																																																																																																																																				
CURRENT TRANSFORMER INPUTS -87B+50BF-2/BU-D130/2A						223	X	X																																																																																																																																																																																																																																																																																																																																																																																																																																																																																																																																																																																																																																																																																				
87B+50BF-2/BU-D01 PROTN.RELAY-BINARY INPUTS						231	X	X																																																																																																																																																																																																																																																																																																																																																																																																																																																																																																																																																																																																																																																																																				
87B+50BF-2/BU-D01PROTN.RELAY-BINARY INPUTS						232	X	X																																																																																																																																																																																																																																																																																																																																																																																																																																																																																																																																																																																																																																																																																				
CBF & BUSBAR PROTN-2 TRIP RELAY CIRCUIT -D01						233	X	X																																																																																																																																																																																																																																																																																																																																																																																																																																																																																																																																																																																																																																																																																				
87B+50BF-2/BU-D130/1A PROTN.RELAY-BINARY INPUTS	234	X	X																																																																																																																																																																																																																																																																																																																																																																																																																																																																																																																																																																																																																																																																																									
87B+50BF-2/BU-D130/1A PROTN.RELAY-BINARY INPUTS	235	X	X																																																																																																																																																																																																																																																																																																																																																																																																																																																																																																																																																																																																																																																																																									
87B+50BF-2/BU-D130/2A PROTN.RELAY-BINARY INPUTS	236	X	X																																																																																																																																																																																																																																																																																																																																																																																																																																																																																																																																																																																																																																																																																									
87B+50BF-2/BU-D130/2A PROTN.RELAY-BINARY INPUTS	237	X	X																																																																																																																																																																																																																																																																																																																																																																																																																																																																																																																																																																																																																																																																																									
CBF & BUSBAR PROTN-2 TRIP RELAY CIRCUIT -D130	238	X	X																																																																																																																																																																																																																																																																																																																																																																																																																																																																																																																																																																																																																																																																																									
B	<table><thead><tr><th>CONTENTS</th><th>ABB SHT.NO.</th><th>REV.00</th><th>REV.01</th><th>REV.02</th></tr></thead><tbody><tr><td>COMMON ALARM CIRCUITS</td><td>292</td><td>X</td><td>X</td><td></td></tr><tr><td>BLOCK REFERENCE 87B+50BF-2/BU-D01</td><td>293</td><td>X</td><td>X</td><td></td></tr><tr><td>BLOCK REFERENCE 87B+50BF-2/BU-D01</td><td>294</td><td>X</td><td>X</td><td></td></tr><tr><td>BLOCK REFERENCE 87B+50BF-2/BU-D130/1A</td><td>295</td><td>X</td><td>X</td><td></td></tr><tr><td>BLOCK REFERENCE 87B+50BF-2/BU-D130/1A</td><td>296</td><td>X</td><td>X</td><td></td></tr><tr><td>BLOCK REFERENCE 87B+50BF-2/BU-D130/2A</td><td>297</td><td>X</td><td>X</td><td></td></tr><tr><td>BLOCK REFERENCE 87B+50BF-2/BU-D130/2A</td><td>298</td><td>X</td><td>X</td><td></td></tr><tr><td>TERMINAL BLOCKS REFERENCE</td><td>301</td><td>X</td><td>X</td><td></td></tr><tr><td></td><td></td><td></td><td></td><td></td></tr><tr><td></td><td></td><td></td><td></td><td></td></trcolspan="5"></td></tr><tr><td colspan="5"></td></tr><tr><td colspan="5"></td></tr><tr><td colspan="5"></td></tr><tr><td colspan="5"></td></tr><tr><td>G</td><td colspan="5"><table><tr><td colspan="2">AS-BUILT BY _____ DATE _____</td><td colspan="2">CONTRACT NO. 11131113/00</td><td colspan="2">JOB ORDER NO. S-13656</td></tr><tr><td colspan="2">01 13 49</td><td colspan="2">FACTORY ASBUILT</td><td colspan="2">DRAWN BY RIZ CHECKED BY KVR</td></tr><tr><td colspan="2">00 13 05</td><td colspan="2">FOR APPROVAL</td><td colspan="2">DATE STARTED 30.01.2013 DATE COMPLETED _____</td></tr><tr><td colspan="2">REV. NO.</td><td colspan="2">DATE</td><td colspan="2">DESCRIPTION</td></tr><tr><td colspan="2"></td><td colspan="2"></td><td colspan="2">OPRG. DEPT. CTPD ENG. DEPT. AUT-PSAC</td></tr></table></td></tr><tr><td colspan="5"><table><tr><td colspan="2">CONTENTS SHEET</td></tr><tr><td colspan="2">32KV BUSBAR PROTN.MAIN-2 BU PANEL +BBP2-3</td></tr><tr><td colspan="2">S/S 8709 - 132/13.8KV IN AL-KHARJ CITY</td></tr><tr><td colspan="2">RIYADH SAUDI ARABIA</td></tr></table></td></tr><tr><td colspan="5"><table><tr><td colspan="2">الشركة الوطنية لنقل الكهرباء</td><td colspan="2">National Grid sa</td></tr><tr><td>INDEX</td><td>PLANT NO.</td><td>DRAWING NUMBER</td><td>SHEET NO.</td><td>REV. NO.</td></tr><tr><td>-</td><td>C421</td><td>CD-323005</td><td>001 011</td><td>01</td></tr></table></td></tr><tr><td colspan="5">NG/D2-D (2012/01)</td></tr><tr><td colspan="5">DMS VECTOR NGD200</td></tr></tbody></table>					CONTENTS	ABB SHT.NO.	REV.00	REV.01	REV.02	COMMON ALARM CIRCUITS	292	X	X		BLOCK REFERENCE 87B+50BF-2/BU-D01	293	X	X		BLOCK REFERENCE 87B+50BF-2/BU-D01	294	X	X		BLOCK REFERENCE 87B+50BF-2/BU-D130/1A	295	X	X		BLOCK REFERENCE 87B+50BF-2/BU-D130/1A	296	X	X		BLOCK REFERENCE 87B+50BF-2/BU-D130/2A	297	X	X		BLOCK REFERENCE 87B+50BF-2/BU-D130/2A	298	X	X		TERMINAL BLOCKS REFERENCE	301	X	X																																																				C																																																																																											D																																																																																						E																																																																																						F																																																																																						G	<table><tr><td colspan="2">AS-BUILT BY _____ DATE _____</td><td colspan="2">CONTRACT NO. 11131113/00</td><td colspan="2">JOB ORDER NO. S-13656</td></tr><tr><td colspan="2">01 13 49</td><td colspan="2">FACTORY ASBUILT</td><td colspan="2">DRAWN BY RIZ CHECKED BY KVR</td></tr><tr><td colspan="2">00 13 05</td><td colspan="2">FOR APPROVAL</td><td colspan="2">DATE STARTED 30.01.2013 DATE COMPLETED _____</td></tr><tr><td colspan="2">REV. NO.</td><td colspan="2">DATE</td><td colspan="2">DESCRIPTION</td></tr><tr><td colspan="2"></td><td colspan="2"></td><td colspan="2">OPRG. DEPT. CTPD ENG. DEPT. AUT-PSAC</td></tr></table>					AS-BUILT BY _____ DATE _____		CONTRACT NO. 11131113/00		JOB ORDER NO. S-13656		01 13 49		FACTORY ASBUILT		DRAWN BY RIZ CHECKED BY KVR		00 13 05		FOR APPROVAL		DATE STARTED 30.01.2013 DATE COMPLETED _____		REV. NO.		DATE		DESCRIPTION						OPRG. DEPT. CTPD ENG. DEPT. AUT-PSAC		<table><tr><td colspan="2">CONTENTS SHEET</td></tr><tr><td colspan="2">32KV BUSBAR PROTN.MAIN-2 BU PANEL +BBP2-3</td></tr><tr><td colspan="2">S/S 8709 - 132/13.8KV IN AL-KHARJ CITY</td></tr><tr><td colspan="2">RIYADH SAUDI ARABIA</td></tr></table>					CONTENTS SHEET		32KV BUSBAR PROTN.MAIN-2 BU PANEL +BBP2-3		S/S 8709 - 132/13.8KV IN AL-KHARJ CITY		RIYADH SAUDI ARABIA		<table><tr><td colspan="2">الشركة الوطنية لنقل الكهرباء</td><td colspan="2">National Grid sa</td></tr><tr><td>INDEX</td><td>PLANT NO.</td><td>DRAWING NUMBER</td><td>SHEET NO.</td><td>REV. NO.</td></tr><tr><td>-</td><td>C421</td><td>CD-323005</td><td>001 011</td><td>01</td></tr></table>					الشركة الوطنية لنقل الكهرباء		National Grid sa		INDEX	PLANT NO.	DRAWING NUMBER	SHEET NO.	REV. NO.	-	C421	CD-323005	001 011	01	NG/D2-D (2012/01)					DMS VECTOR NGD200																																																																																																																																																	
CONTENTS						ABB SHT.NO.	REV.00	REV.01	REV.02																																																																																																																																																																																																																																																																																																																																																																																																																																																																																																																																																																																																																																																																																			
COMMON ALARM CIRCUITS						292	X	X																																																																																																																																																																																																																																																																																																																																																																																																																																																																																																																																																																																																																																																																																				
BLOCK REFERENCE 87B+50BF-2/BU-D01						293	X	X																																																																																																																																																																																																																																																																																																																																																																																																																																																																																																																																																																																																																																																																																				
BLOCK REFERENCE 87B+50BF-2/BU-D01						294	X	X																																																																																																																																																																																																																																																																																																																																																																																																																																																																																																																																																																																																																																																																																				
BLOCK REFERENCE 87B+50BF-2/BU-D130/1A						295	X	X																																																																																																																																																																																																																																																																																																																																																																																																																																																																																																																																																																																																																																																																																				
BLOCK REFERENCE 87B+50BF-2/BU-D130/1A						296	X	X																																																																																																																																																																																																																																																																																																																																																																																																																																																																																																																																																																																																																																																																																				
BLOCK REFERENCE 87B+50BF-2/BU-D130/2A						297	X	X																																																																																																																																																																																																																																																																																																																																																																																																																																																																																																																																																																																																																																																																																				
BLOCK REFERENCE 87B+50BF-2/BU-D130/2A						298	X	X																																																																																																																																																																																																																																																																																																																																																																																																																																																																																																																																																																																																																																																																																				
TERMINAL BLOCKS REFERENCE						301	X	X																																																																																																																																																																																																																																																																																																																																																																																																																																																																																																																																																																																																																																																																																				
C																																																																																																																																																																																																																																																																																																																																																																																																																																																																																																																																																																																																																																																																																												
D																																																																																																																																																																																																																																																																																																																																																																																																																																																																																																																																																																																																																																																																																												
E																																																																																																																																																																																																																																																																																																																																																																																																																																																																																																																																																																																																																																																																																												
F																																																																																																																																																																																																																																																																																																																																																																																																																																																																																																																																																																																																																																																																																												
G	<table><tr><td colspan="2">AS-BUILT BY _____ DATE _____</td><td colspan="2">CONTRACT NO. 11131113/00</td><td colspan="2">JOB ORDER NO. S-13656</td></tr><tr><td colspan="2">01 13 49</td><td colspan="2">FACTORY ASBUILT</td><td colspan="2">DRAWN BY RIZ CHECKED BY KVR</td></tr><tr><td colspan="2">00 13 05</td><td colspan="2">FOR APPROVAL</td><td colspan="2">DATE STARTED 30.01.2013 DATE COMPLETED _____</td></tr><tr><td colspan="2">REV. NO.</td><td colspan="2">DATE</td><td colspan="2">DESCRIPTION</td></tr><tr><td colspan="2"></td><td colspan="2"></td><td colspan="2">OPRG. DEPT. CTPD ENG. DEPT. AUT-PSAC</td></tr></table>										AS-BUILT BY _____ DATE _____		CONTRACT NO. 11131113/00		JOB ORDER NO. S-13656		01 13 49		FACTORY ASBUILT		DRAWN BY RIZ CHECKED BY KVR		00 13 05		FOR APPROVAL		DATE STARTED 30.01.2013 DATE COMPLETED _____		REV. NO.		DATE		DESCRIPTION						OPRG. DEPT. CTPD ENG. DEPT. AUT-PSAC																																																																																																																																																																																																																																																																																																																																																																																																																																																																																																																																																																																																																																																					
AS-BUILT BY _____ DATE _____		CONTRACT NO. 11131113/00		JOB ORDER NO. S-13656																																																																																																																																																																																																																																																																																																																																																																																																																																																																																																																																																																																																																																																																																								
01 13 49		FACTORY ASBUILT		DRAWN BY RIZ CHECKED BY KVR																																																																																																																																																																																																																																																																																																																																																																																																																																																																																																																																																																																																																																																																																								
00 13 05		FOR APPROVAL		DATE STARTED 30.01.2013 DATE COMPLETED _____																																																																																																																																																																																																																																																																																																																																																																																																																																																																																																																																																																																																																																																																																								
REV. NO.		DATE		DESCRIPTION																																																																																																																																																																																																																																																																																																																																																																																																																																																																																																																																																																																																																																																																																								
				OPRG. DEPT. CTPD ENG. DEPT. AUT-PSAC																																																																																																																																																																																																																																																																																																																																																																																																																																																																																																																																																																																																																																																																																								
<table><tr><td colspan="2">CONTENTS SHEET</td></tr><tr><td colspan="2">32KV BUSBAR PROTN.MAIN-2 BU PANEL +BBP2-3</td></tr><tr><td colspan="2">S/S 8709 - 132/13.8KV IN AL-KHARJ CITY</td></tr><tr><td colspan="2">RIYADH SAUDI ARABIA</td></tr></table>					CONTENTS SHEET		32KV BUSBAR PROTN.MAIN-2 BU PANEL +BBP2-3		S/S 8709 - 132/13.8KV IN AL-KHARJ CITY		RIYADH SAUDI ARABIA																																																																																																																																																																																																																																																																																																																																																																																																																																																																																																																																																																																																																																																																																	
CONTENTS SHEET																																																																																																																																																																																																																																																																																																																																																																																																																																																																																																																																																																																																																																																																																												
32KV BUSBAR PROTN.MAIN-2 BU PANEL +BBP2-3																																																																																																																																																																																																																																																																																																																																																																																																																																																																																																																																																																																																																																																																																												
S/S 8709 - 132/13.8KV IN AL-KHARJ CITY																																																																																																																																																																																																																																																																																																																																																																																																																																																																																																																																																																																																																																																																																												
RIYADH SAUDI ARABIA																																																																																																																																																																																																																																																																																																																																																																																																																																																																																																																																																																																																																																																																																												
<table><tr><td colspan="2">الشركة الوطنية لنقل الكهرباء</td><td colspan="2">National Grid sa</td></tr><tr><td>INDEX</td><td>PLANT NO.</td><td>DRAWING NUMBER</td><td>SHEET NO.</td><td>REV. NO.</td></tr><tr><td>-</td><td>C421</td><td>CD-323005</td><td>001 011</td><td>01</td></tr></table>					الشركة الوطنية لنقل الكهرباء		National Grid sa		INDEX	PLANT NO.	DRAWING NUMBER	SHEET NO.	REV. NO.	-	C421	CD-323005	001 011	01																																																																																																																																																																																																																																																																																																																																																																																																																																																																																																																																																																																																																																																																										
الشركة الوطنية لنقل الكهرباء		National Grid sa																																																																																																																																																																																																																																																																																																																																																																																																																																																																																																																																																																																																																																																																																										
INDEX	PLANT NO.	DRAWING NUMBER	SHEET NO.	REV. NO.																																																																																																																																																																																																																																																																																																																																																																																																																																																																																																																																																																																																																																																																																								
-	C421	CD-323005	001 011	01																																																																																																																																																																																																																																																																																																																																																																																																																																																																																																																																																																																																																																																																																								
NG/D2-D (2012/01)																																																																																																																																																																																																																																																																																																																																																																																																																																																																																																																																																																																																																																																																																												
DMS VECTOR NGD200																																																																																																																																																																																																																																																																																																																																																																																																																																																																																																																																																																																																																																																																																												

THIS DRAWING AND THE INFORMATION CONTAINED HEREIN ARE THE SOLE PROPERTY OF National Grid SA NO REPRODUCTION IN FULL OR IN PART SHALL BE OBTAINED FROM THIS DOCUMENT WITHOUT THE WRITTEN CONSENT OF ITS OWNER.

	1	2	3	4	5	6	7	8	9	10																																																																																																																		
A																																																																																																																												
B																																																																																																																												
C																																																																																																																												
D																																																																																																																												
E																																																																																																																												
F																																																																																																																												
	<table><tr><th>SYMBOL</th><th>DESCRIPTION</th><th>SYMBOL</th><th>DESCRIPTION</th><th>SYMBOL</th><th>DESCRIPTION</th></tr><tr><td></td><td>FRAME CONNECTION</td><td></td><td>MAIN CONTACT OF A CIRCUIT BREAKER</td><td></td><td>RELAY WITH TWO MAKE CONTACTS, ONE OF THEM DELAYED WHEN OPERATING</td></tr><tr><td></td><td>EARTH CONNECTION</td><td></td><td>PASSING MAKE CONTACT CLOSING MOMENTARILY DURING OPERATION AND RELEASE</td><td></td><td>RELAY WITH TWO ACTUATORS AND A TWO STABLE POSITIONS</td></tr><tr><td></td><td>RESISTOR</td><td></td><td>BREAK CONTACT DELAYED WHEN OPERATING</td><td></td><td></td></tr><tr><td></td><td>VARIABLE RESISTOR</td><td></td><td>MAKE CONTACT DELAYED WHEN RELEASING</td><td></td><td>SIGNALLING LAMP</td></tr><tr><td></td><td>RESISTOR WITH PRESET ADJUSTMENT</td><td></td><td>TWO MECHANICAL LINKS CROSSING WITHOUT CONNECTION</td><td></td><td>MECHANICAL INDICATOR WITH AUTOMATIC RESET</td></tr><tr><td></td><td>CAPACITOR</td><td></td><td>JUNCTION OF MECHANICAL LINKS</td><td></td><td>MECHANICAL INDICATOR WITH NON-AUTOMATIC RESET</td></tr><tr><td></td><td>SEMICONDUCTOR DIODE USED AS A CAPACITIVE DEVICE</td><td></td><td>AUTOMATIC RESET</td><td></td><td>ELECTRICALLY CONTROLLED MECHANICAL INDICATOR WITH AUTOMATIC RESET</td></tr><tr><td></td><td>OPEN CONTACT, MAKE CONTACT</td><td></td><td>NON-AUTOMATIC RESET</td><td></td><td>ELECTRICALLY CONTROLLED MECHANICAL INDICATOR WITH NON-AUTOMATIC RESET</td></tr><tr><td></td><td>CLOSED CONTACT, BREAK CONTACT</td><td></td><td>SWITCHING DEVICE WITH MANUAL OPERATION AND WITH AUTOMATIC RESET</td><td></td><td>RELAY WITH MAKE CONTACT</td></tr><tr><td></td><td>CHANGE-OVER CONTACT, BREAK BEFORE MAKE</td><td></td><td>SWITCHING DEVICE WITH MANUAL OPERATION AND WITH NON-AUTOMATIC RESET</td><td></td><td>RELAY WITH CHANGE-OVER CONTACT</td></tr><tr><td></td><td>MAKE CONTACT WHICH IS EARLY WHEN OPERATING AND LATE WHEN RELEASING</td><td></td><td>CHANGE-OVER SWITCHING DEVICE WITH MANUAL CONTROL</td><td></td><td>RELAY WITH MAKE CONTACT, DELAYED WHEN OPERATING</td></tr><tr><td></td><td>BREAK CONTACT WHICH IS LATE WHEN OPERATING AND EARLY WHEN RELEASING</td><td></td><td>RELAY WITH MAKE CONTACT, DELAYED WHEN RELEASING</td><td></td><td>RELAY WITH MAKE CONTACT, DELAYED WHEN OPERATING AND RELEASING</td></tr><tr><td></td><td>SWITCHING DEVICE WITH MANUAL CONTROL</td><td></td><td></td><td></td><td></td></tr><tr><td></td><td>MAKE CONTACT DELAYED WHEN OPERATING</td><td></td><td></td><td></td><td></td></tr><tr><td></td><td>BREAK CONTACT DELAYED WHEN RELEASING</td><td></td><td></td><td></td><td></td></tr><tr><td></td><td>MAKE CONTACT DELAYED WHEN OPERATING AND RELEASING</td><td></td><td></td><td></td><td></td></tr><tr><td></td><td>MAIN CONTACT OF A SWITCH DISCONNECTOR</td><td></td><td></td><td></td><td></td></tr><tr><td></td><td>MAIN CONTACT OF A DISCONNECTOR</td><td></td><td></td><td></td><td></td></tr></table>										SYMBOL	DESCRIPTION	SYMBOL	DESCRIPTION	SYMBOL	DESCRIPTION		FRAME CONNECTION		MAIN CONTACT OF A CIRCUIT BREAKER		RELAY WITH TWO MAKE CONTACTS, ONE OF THEM DELAYED WHEN OPERATING		EARTH CONNECTION		PASSING MAKE CONTACT CLOSING MOMENTARILY DURING OPERATION AND RELEASE		RELAY WITH TWO ACTUATORS AND A TWO STABLE POSITIONS		RESISTOR		BREAK CONTACT DELAYED WHEN OPERATING				VARIABLE RESISTOR		MAKE CONTACT DELAYED WHEN RELEASING		SIGNALLING LAMP		RESISTOR WITH PRESET ADJUSTMENT		TWO MECHANICAL LINKS CROSSING WITHOUT CONNECTION		MECHANICAL INDICATOR WITH AUTOMATIC RESET		CAPACITOR		JUNCTION OF MECHANICAL LINKS		MECHANICAL INDICATOR WITH NON-AUTOMATIC RESET		SEMICONDUCTOR DIODE USED AS A CAPACITIVE DEVICE		AUTOMATIC RESET		ELECTRICALLY CONTROLLED MECHANICAL INDICATOR WITH AUTOMATIC RESET		OPEN CONTACT, MAKE CONTACT		NON-AUTOMATIC RESET		ELECTRICALLY CONTROLLED MECHANICAL INDICATOR WITH NON-AUTOMATIC RESET		CLOSED CONTACT, BREAK CONTACT		SWITCHING DEVICE WITH MANUAL OPERATION AND WITH AUTOMATIC RESET		RELAY WITH MAKE CONTACT		CHANGE-OVER CONTACT, BREAK BEFORE MAKE		SWITCHING DEVICE WITH MANUAL OPERATION AND WITH NON-AUTOMATIC RESET		RELAY WITH CHANGE-OVER CONTACT		MAKE CONTACT WHICH IS EARLY WHEN OPERATING AND LATE WHEN RELEASING		CHANGE-OVER SWITCHING DEVICE WITH MANUAL CONTROL		RELAY WITH MAKE CONTACT, DELAYED WHEN OPERATING		BREAK CONTACT WHICH IS LATE WHEN OPERATING AND EARLY WHEN RELEASING		RELAY WITH MAKE CONTACT, DELAYED WHEN RELEASING		RELAY WITH MAKE CONTACT, DELAYED WHEN OPERATING AND RELEASING		SWITCHING DEVICE WITH MANUAL CONTROL						MAKE CONTACT DELAYED WHEN OPERATING						BREAK CONTACT DELAYED WHEN RELEASING						MAKE CONTACT DELAYED WHEN OPERATING AND RELEASING						MAIN CONTACT OF A SWITCH DISCONNECTOR						MAIN CONTACT OF A DISCONNECTOR				
SYMBOL	DESCRIPTION	SYMBOL	DESCRIPTION	SYMBOL	DESCRIPTION																																																																																																																							
	FRAME CONNECTION		MAIN CONTACT OF A CIRCUIT BREAKER		RELAY WITH TWO MAKE CONTACTS, ONE OF THEM DELAYED WHEN OPERATING																																																																																																																							
	EARTH CONNECTION		PASSING MAKE CONTACT CLOSING MOMENTARILY DURING OPERATION AND RELEASE		RELAY WITH TWO ACTUATORS AND A TWO STABLE POSITIONS																																																																																																																							
	RESISTOR		BREAK CONTACT DELAYED WHEN OPERATING																																																																																																																									
	VARIABLE RESISTOR		MAKE CONTACT DELAYED WHEN RELEASING		SIGNALLING LAMP																																																																																																																							
	RESISTOR WITH PRESET ADJUSTMENT		TWO MECHANICAL LINKS CROSSING WITHOUT CONNECTION		MECHANICAL INDICATOR WITH AUTOMATIC RESET																																																																																																																							
	CAPACITOR		JUNCTION OF MECHANICAL LINKS		MECHANICAL INDICATOR WITH NON-AUTOMATIC RESET																																																																																																																							
	SEMICONDUCTOR DIODE USED AS A CAPACITIVE DEVICE		AUTOMATIC RESET		ELECTRICALLY CONTROLLED MECHANICAL INDICATOR WITH AUTOMATIC RESET																																																																																																																							
	OPEN CONTACT, MAKE CONTACT		NON-AUTOMATIC RESET		ELECTRICALLY CONTROLLED MECHANICAL INDICATOR WITH NON-AUTOMATIC RESET																																																																																																																							
	CLOSED CONTACT, BREAK CONTACT		SWITCHING DEVICE WITH MANUAL OPERATION AND WITH AUTOMATIC RESET		RELAY WITH MAKE CONTACT																																																																																																																							
	CHANGE-OVER CONTACT, BREAK BEFORE MAKE		SWITCHING DEVICE WITH MANUAL OPERATION AND WITH NON-AUTOMATIC RESET		RELAY WITH CHANGE-OVER CONTACT																																																																																																																							
	MAKE CONTACT WHICH IS EARLY WHEN OPERATING AND LATE WHEN RELEASING		CHANGE-OVER SWITCHING DEVICE WITH MANUAL CONTROL		RELAY WITH MAKE CONTACT, DELAYED WHEN OPERATING																																																																																																																							
	BREAK CONTACT WHICH IS LATE WHEN OPERATING AND EARLY WHEN RELEASING		RELAY WITH MAKE CONTACT, DELAYED WHEN RELEASING		RELAY WITH MAKE CONTACT, DELAYED WHEN OPERATING AND RELEASING																																																																																																																							
	SWITCHING DEVICE WITH MANUAL CONTROL																																																																																																																											
	MAKE CONTACT DELAYED WHEN OPERATING																																																																																																																											
	BREAK CONTACT DELAYED WHEN RELEASING																																																																																																																											
	MAKE CONTACT DELAYED WHEN OPERATING AND RELEASING																																																																																																																											
	MAIN CONTACT OF A SWITCH DISCONNECTOR																																																																																																																											
	MAIN CONTACT OF A DISCONNECTOR																																																																																																																											
G	<table><tr><td colspan="3">AS-BUILT BY _____ DATE _____</td><td colspan="2">CONTRACT NO. 11131113/00</td><td colspan="2">JOB ORDER NO. S-13656</td><td colspan="2">GRAPHICAL SYMBOLS FOR DIAGRAMS</td><td colspan="2">الشركة الوطنية لنقل الكهرباء</td></tr><tr><td>01</td><td>13 49</td><td>FACTORY ASBUILT</td><td colspan="2">DRAWN BY RIZ</td><td colspan="2">CHECKED BY KVR</td><td colspan="2">32KV BUSBAR PROTN.MAIN-2 BU PANEL +BBP2-3</td><td colspan="2">National Grid sa</td></tr><tr><td>00</td><td>13 05</td><td>FOR APPROVAL</td><td colspan="2">DATE STARTED 30.01.2013</td><td colspan="2">DATE COMPLETED _____</td><td colspan="2">S/S 8709 - 132/13.8KV IN AL-KHARJ CITY</td><td colspan="2"></td></tr><tr><td>REV. NO.</td><td>DATE</td><td>DESCRIPTION</td><td colspan="2">OPRG. DEPT. CTPD</td><td colspan="2">ENG. DEPT. AUT-PSAC</td><td colspan="2">RIYADH SAUDI ARABIA</td><td colspan="2"></td></tr></table>										AS-BUILT BY _____ DATE _____			CONTRACT NO. 11131113/00		JOB ORDER NO. S-13656		GRAPHICAL SYMBOLS FOR DIAGRAMS		الشركة الوطنية لنقل الكهرباء		01	13 49	FACTORY ASBUILT	DRAWN BY RIZ		CHECKED BY KVR		32KV BUSBAR PROTN.MAIN-2 BU PANEL +BBP2-3		National Grid sa		00	13 05	FOR APPROVAL	DATE STARTED 30.01.2013		DATE COMPLETED _____		S/S 8709 - 132/13.8KV IN AL-KHARJ CITY				REV. NO.	DATE	DESCRIPTION	OPRG. DEPT. CTPD		ENG. DEPT. AUT-PSAC		RIYADH SAUDI ARABIA																																																																									
AS-BUILT BY _____ DATE _____			CONTRACT NO. 11131113/00		JOB ORDER NO. S-13656		GRAPHICAL SYMBOLS FOR DIAGRAMS		الشركة الوطنية لنقل الكهرباء																																																																																																																			
01	13 49	FACTORY ASBUILT	DRAWN BY RIZ		CHECKED BY KVR		32KV BUSBAR PROTN.MAIN-2 BU PANEL +BBP2-3		National Grid sa																																																																																																																			
00	13 05	FOR APPROVAL	DATE STARTED 30.01.2013		DATE COMPLETED _____		S/S 8709 - 132/13.8KV IN AL-KHARJ CITY																																																																																																																					
REV. NO.	DATE	DESCRIPTION	OPRG. DEPT. CTPD		ENG. DEPT. AUT-PSAC		RIYADH SAUDI ARABIA																																																																																																																					
	<table><tr><td>INDEX</td><td>PLANT NO.</td><td>DRAWING NUMBER</td><td>SHEET NO.</td><td>REV. NO.</td></tr><tr><td>-</td><td>C421</td><td>CD-323005</td><td>011 012</td><td>01</td></tr></table>										INDEX	PLANT NO.	DRAWING NUMBER	SHEET NO.	REV. NO.	-	C421	CD-323005	011 012	01																																																																																																								
INDEX	PLANT NO.	DRAWING NUMBER	SHEET NO.	REV. NO.																																																																																																																								
-	C421	CD-323005	011 012	01																																																																																																																								

THIS DRAWING AND THE INFORMATION CONTAINED HEREIN ARE THE SOLE PROPERTY OF NATIONAL GRID SA. NO REPRODUCTION IN FULL OR IN PART SHALL BE OBTAINED FROM THIS DOCUMENT WITHOUT THE WRITTEN CONSENT OF ITS OWNER.

	1	2	3	4	5	6	7	8	9	10
A										
B										
C										
D										
E										
F										

SYMBOL	DESCRIPTION	SYMBOL	DESCRIPTION	SYMBOL	DESCRIPTION
	FUSE / LINK		WATTMETER		ELEMENT WITH NEGATED INHIBITING INPUT
	FUSE WITH THE SUPPLY SIDE INDICATED		VARMETER		ELEMENT WITH INPUT WHICH DOES NOT CARRY ANY LOGIC INFORMATION
	SINGLE-PHASE TRANSFORMER WITH TWO SEPARATE WINDINGS (TWO ALTERNATIVE FORMS)		POWER FACTOR METER		ELEMENT WITH POSTPONED OUTPUT
	SINGLE-PHASE TRANSFORMER WITH THREE SEPARATE WINDINGS (TWO ALTERNATIVE FORMS)		POSITION INDICATOR		AND-ELEMENT WITH TWO INPUTS
	SINGLE-PHASE TRANSFORMER WITH FERRO MAGNETIC CORE		SYNCHROSCOPE		OR-ELEMENT WITH TWO INPUTS
	SINGLE-PHASE VOLTAGE TRANSFORMER (MULTI-LINE AND SINGLE-LINE REPRESENTATION)		RECORDING VOLTMETER		LOGIC THRESHOLD ELEMENT WITH FOUR INPUTS AND THRESHOLD VALUE 2
	SINGLE-PHASE VOLTAGE TRANSFORMER WITH TWO SECONDARY WINDINGS (MULTI-LINE AND SINGLE-LINE REPRESENTATION)		RECORDING WATTMETER		ELEMENT WITH THREE INPUTS FOR "2 AND ONLY 2"
	CURRENT TRANSFORMER (MULTI-LINE AND SINGLE-LINE REPRESENTATION)		HOUR METER		EXCLUSIVE OR-ELEMENT WITH THREE INPUTS
	CURRENT TRANSFORMER WITH TWO CORES (MULTI-LINE AND SINGLE-LINE REPRESENTATION)		WATT-HOUR METER		LOGIC IDENTITY ELEMENT WITH THREE INPUTS
	CURRENT TRANSFORMER WITH TWO SECONDARY WINDINGS ON ONE CORE (MULTI-LINE AND SINGLE-LINE REPRESENTATION)		WATT-HOUR METER FOR ENERGY FROM A BUSBAR SYSTEM		MAJORITY ELEMENT WITH THREE INPUTS
	FILTER		ELEMENT WITH STATIC INPUT		NEGATOR
	HIGH-PASS FILTER		ELEMENT WITH STATIC NEGATED INPUT		NAND ELEMENT WITH TWO INPUTS
	BAND-PASS FILTER		ELEMENT WITH STATIC NEGATED OUTPUT		NOR ELEMENT WITH TWO INPUTS
	VOLTMETER		ELEMENT WITH DYNAMIC INPUT		BISTABLE ELEMENT
	AMMETER		ELEMENT WITH DYNAMIC NEGATED INPUT		
			ELEMENT WITH INHIBITING INPUT		

AS-BUILT BY

DATE

CONTRACT NO.

11131113/00

JOB ORDER NO.

S-13656

GRAPHICAL SYMBOLS FOR DIAGRAMS

01

13 49

FACTORY ASBUILT

00

13 05

FOR APPROVAL

REV. NO.

DATE

DESCRIPTION

DRAWN BY

RIZ

CHECKED BY

KVR

DATE STARTED

30.01.2013

DATE COMPLETED

OPRG. DEPT.

CTPD

ENG. DEPT.

AUT-PSAC

132KV BUSBAR PROTN.MAIN-2 BU PANEL +BBP2-3

S/S 8709 - 132/13.8KV IN AL-KHARJ CITY

RIYADH SAUDI ARABIA

الشركة الوطنية لنقل الكهرباء

نقل الكهرباء

National Grid sa

INDEX

PLANT NO.

DRAWING NUMBER

SHEET NO.

REV. NO.

C421

CD-323005

012013

01

	1	2	3	4	5	6	7	8	9	10
A										
B										
C										
D										
E										
F										

LEGENDS

±R1	DC SUPPLY – MAIN PROTECTION
±R2	DC SUPPLY – SECONDARY PROTECTION
±R3	DC SUPPLY – BACK UP PROTECTION
±IT	DC SUPPLY – INTER TRIP
FL	DC SUPPLY – FLASHING CIRCUIT
BB RS±	DC SUPPLY – BUS BAR – PROTECTION RESET
BB CBF±/CBF±	DC SUPPLY – CBF PROTECTION
R	RESET BUS – ALARM SYSTEM
CR	CONTROL ROOM
ECC	ENERGY CONTROL CENTRE
LOCAL	THE LOCATION OF CONTROLLED DEVICE
REMOTE	ANY OTHER LOCATION NOT LOCAL
ON	CB NORMALLY OPEN AUXILIARY CONTACT
OFF	CB NORMALLY CLOSED AUXILIARY CONTACT
A	COMMON
T	TEST POSITION
S	SERVICE POSITION
CS	CLOSE IN SERVICE POSITION
CT	CLOSE IN TEST POSITION
LS	LOCAL SERVICE
LT	LOCAL TEST
LC	LOCAL CLOSE
LO	LOCAL OPEN
RO	REMOTE OPEN
OP	OPERATE
RE	RESET

NOTES

LABELS

WHITE LABEL WITH BLACK LETTERING WILL BE PROVIDED FOR ALL MOUNTED APPARATUS EQUIPMENT IDENTIFICATION AND FUNCTION REFERENCE LABEL WILL BE PROVIDED FOR FRONT MOUNTED EQUIPMENTS OF THE PANEL AND EQUIPMENT IDENTIFICATION LABEL WILL BE PROVIDED FOR INTERNALLY MOUNTED EQUIPMENTS

WIRING

PVC INSULATED 600V GRADE
 2.5 SQ.mm. YELLOW COLOURED FOR CT CIRCUITS
 2.5 SQ.mm. RE COLOURED FOR VT CIRCUITS
 1.5 SQ.mm. GREY COLOURED FOR DC SUPPLY, SCADA AND CONTROL CIRCUITS
 2.5 SQ.mm. BLACK COLOURED FOR AVC AND AC CIRCUITS
 2.5 SQ.mm. YELLOW/GREEN COLOURED FOR EARTHING CONNECTIONS
 FOLLOWING MARKERS SHALL BE PROVIDED ON FOLLOWING WIRES:
 + SIGN FOR DC + WIRE
 – SIGN FOR DC – WIRE


LUGS

A. CT CIRCUITS– RING TYPE
 B. OTHER CIRCUITS – SPADE TYPE


FERULLING

YELLO TUBE 3.2 mm FOR 1.5SQ mm WIRES AND 4.2 FOR 2.5 SQ mm WIRES
 (AS PER 31 – TMSS–1, RE.0)


AS-BUILT BY _____ DATE _____			CONTRACT NO. 11131113/00		JOB ORDER NO. S-13656		COMMON LEGEND				الشركة الوطنية لنقل الكهرباء National Grid sa			
01	13 49	FACTORY ASBUILT	DRAWN BY RIZ		CHECKED BY KVR		132KV BUSBAR PROTN.MAIN-2 BU PANEL +BBP2-3				INDEX	PLANT NO.	DRAWING NUMBER	SHEET NO.
00	13 05	FOR APPROVAL	DATE STARTED 30.01.2013		DATE COMPLETED		S/S 8709 - 132/13.8KV IN AL-KHARJ CITY				-	C421	CD-323005	SHT CONT.
REV. NO.	DATE	DESCRIPTION	OPRG. DEPT. CTPD		ENG. DEPT. AUT-PSAC		RIYADH SAUDI ARABIA							013 014

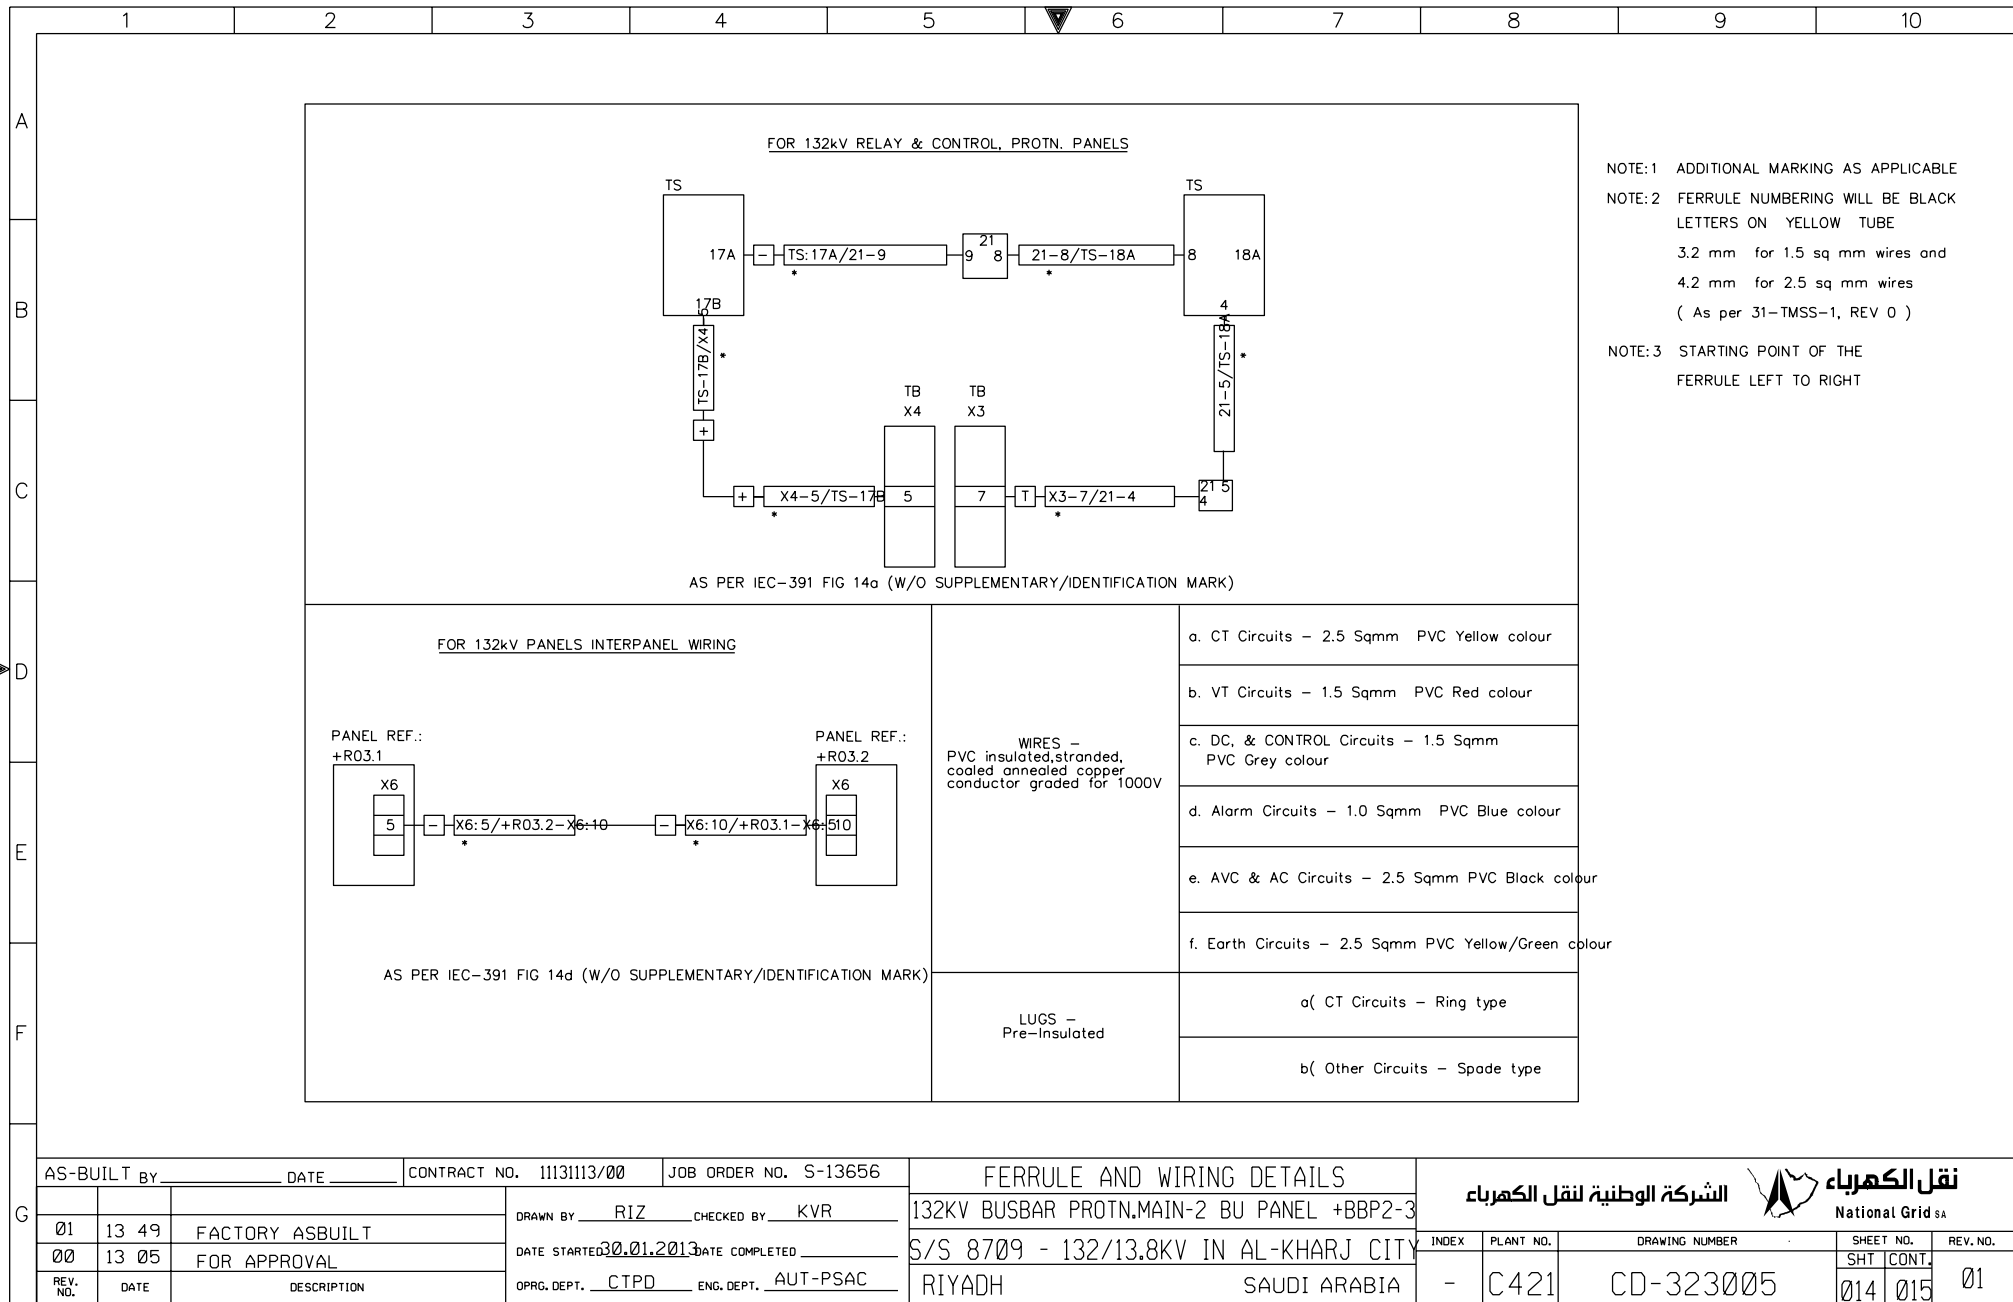




	1	2	3	4	5	6	7	8	9	10
A										
B										
C										
D										
E										
F										
G										
AS-BUILT BY _____ DATE _____		CONTRACT NO. 11131113/00		JOB ORDER NO. S-13656		DRAWING REFERENCES		الشركة الوطنية لنقل الكهرباء		نقل الكهرباء
01 13 49		FACTORY ASBUILT		DRAWN BY RIZ CHECKED BY KVR		132KV BUSBAR PROTN.MAIN-2 BU PANEL +BBP2-3		National Grid sa		
00 13 05		FOR APPROVAL		DATE STARTED 30.01.2013 DATE COMPLETED		S/S 8709 - 132/13.8KV IN AL-KHARJ CITY		SHEET NO.		REV. NO.
REV. NO.		DATE		DESCRIPTION		PRG. DEPT. CTPD ENG. DEPT. AUT-PSAC		R15 R16		01
						RIYADH SAUDI ARABIA		INDEX PLANT NO. DRAWING NUMBER		
								- C421 CD-323005		
								SHT CONT.		
								NG/D2-D (2012/01)		
								DMS VECTOR		NGD200

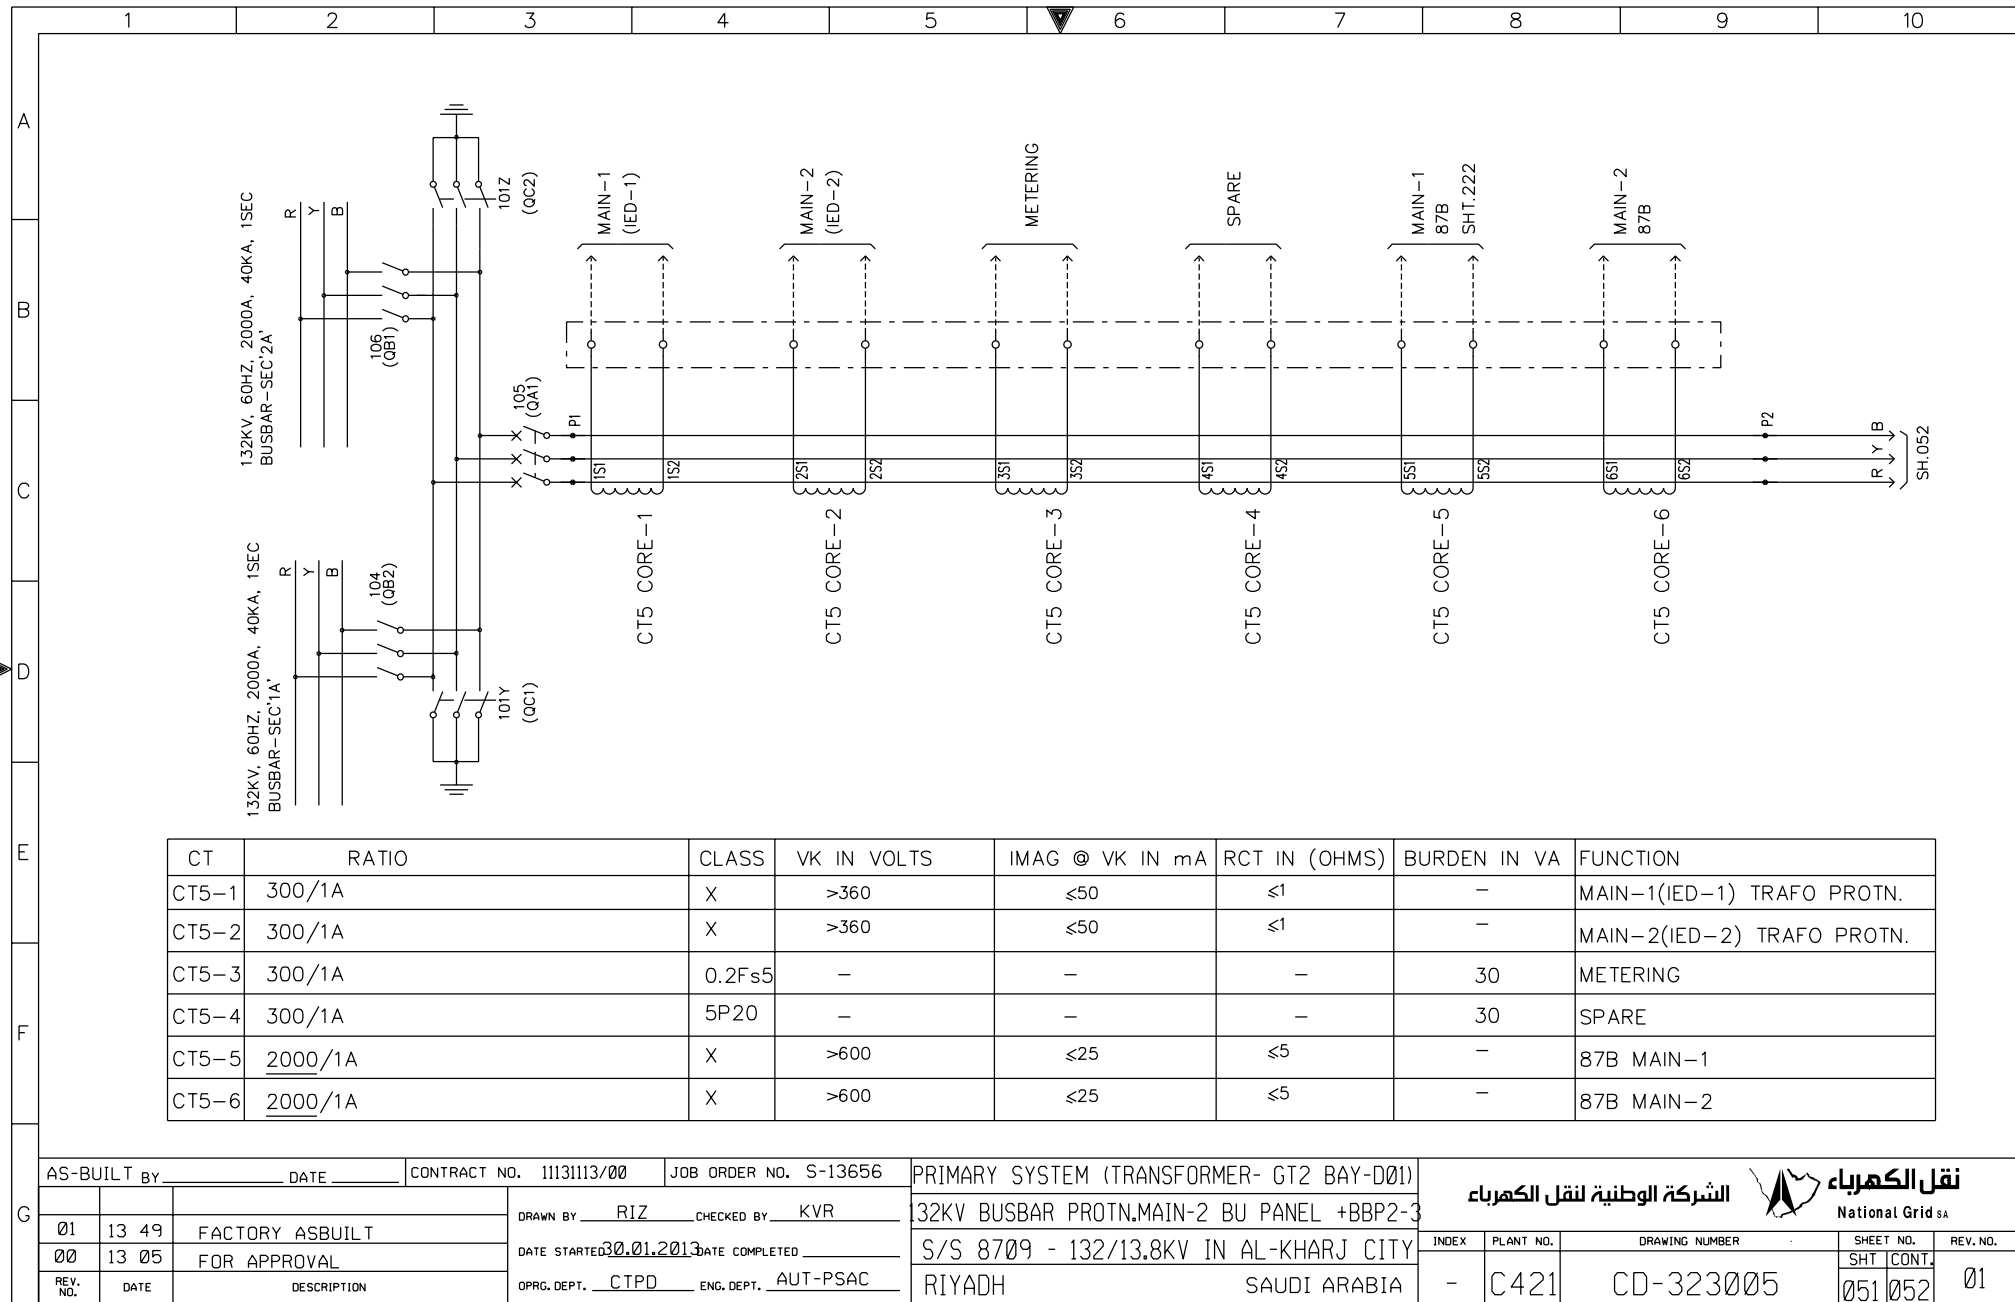


THIS DRAWING AND THE INFORMATION CONTAINED HEREIN ARE THE SOLE PROPERTY OF NGD200. NO REPRODUCTION IN FULL OR IN PART SHALL BE OBTAINED FROM THIS DOCUMENT WITHOUT THE WRITTEN CONSENT OF ITS OWNER.

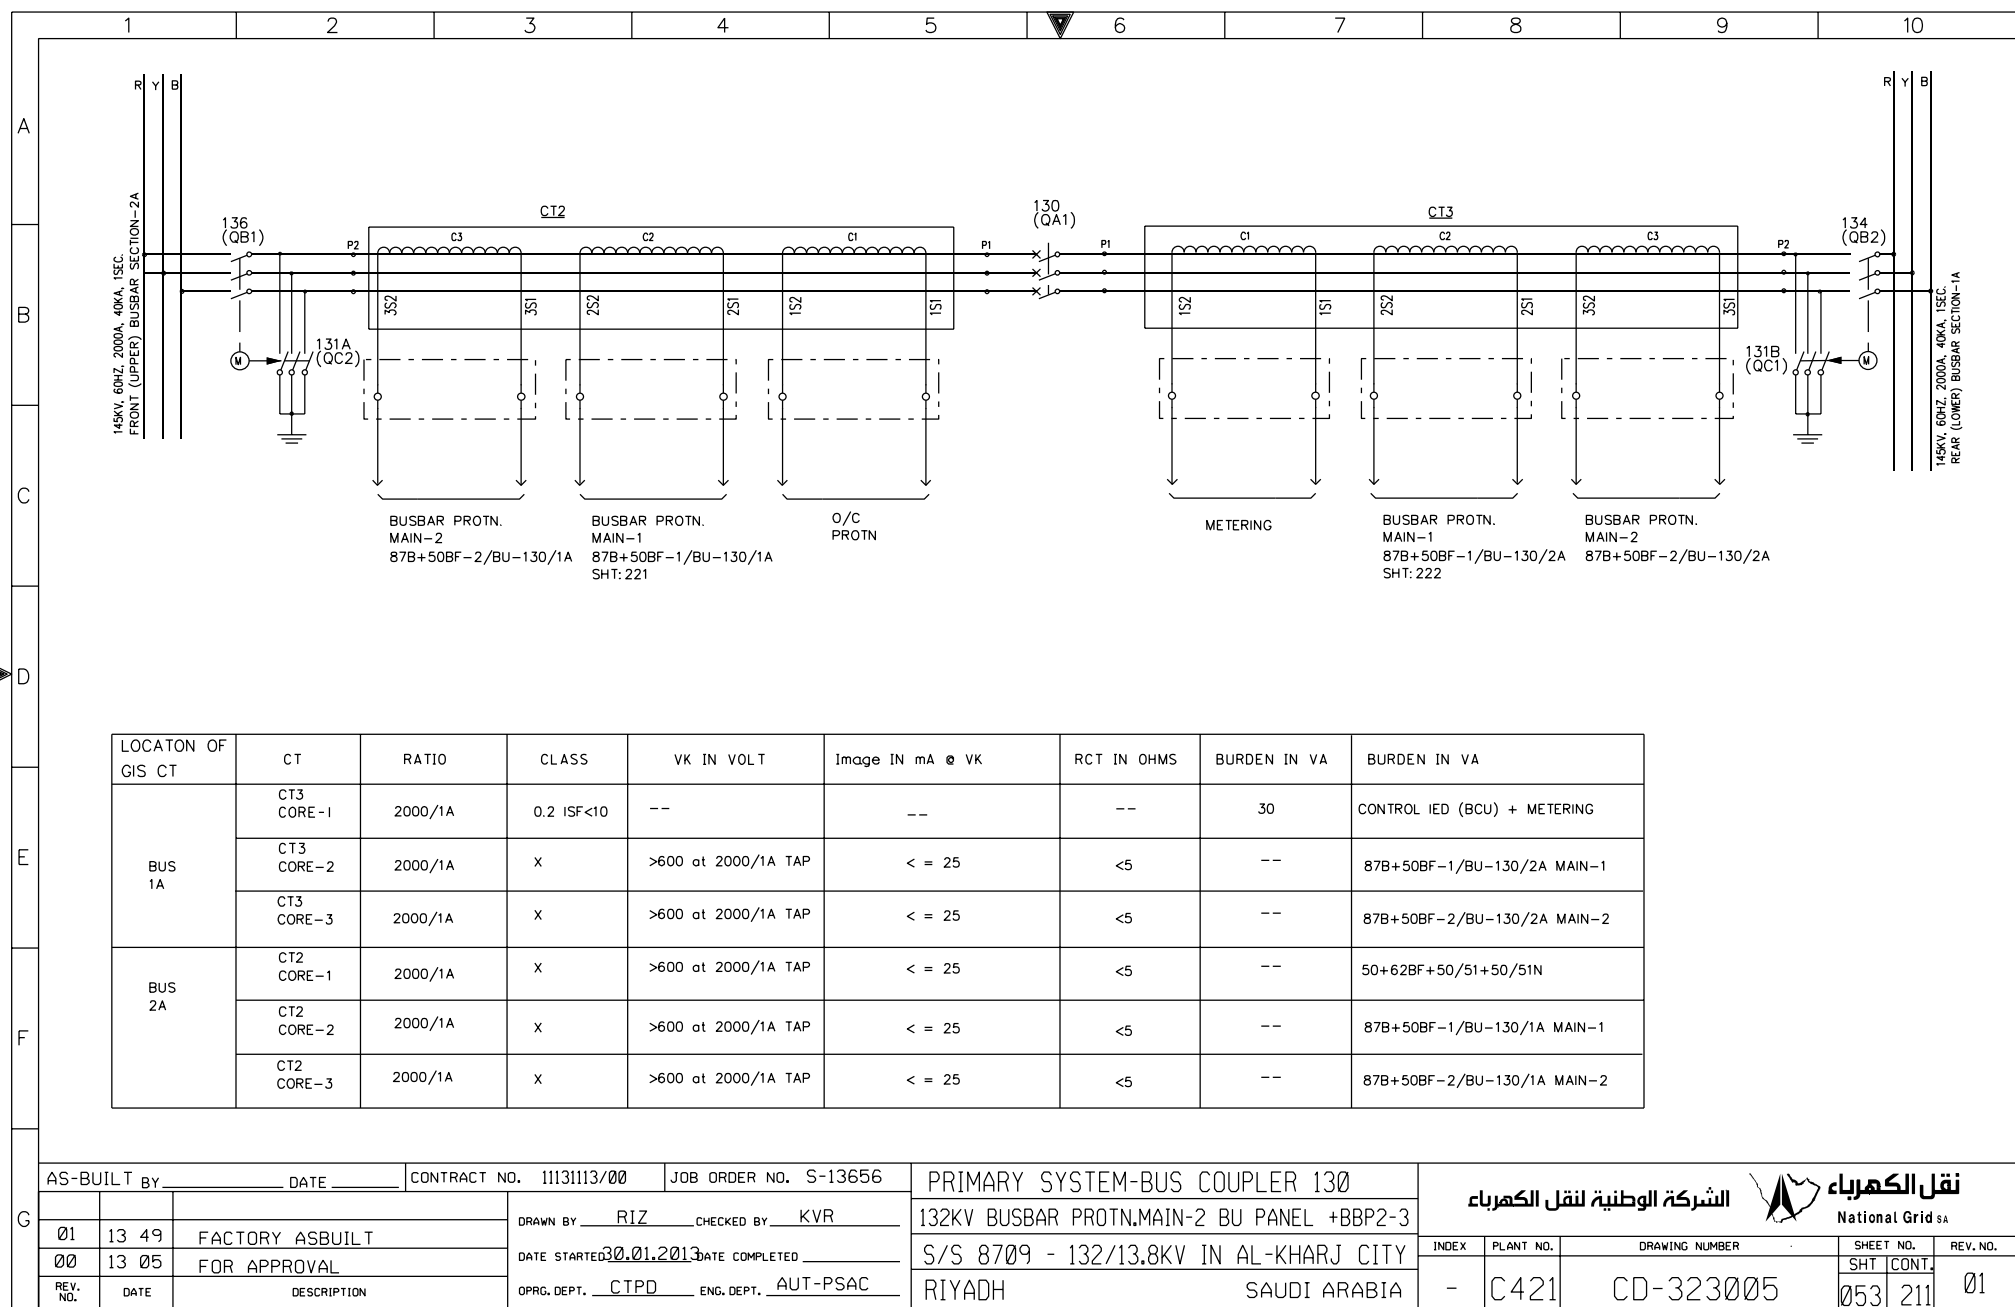


THIS DRAWING AND THE INFORMATION CONTAINED HEREIN ARE THE SOLE PROPERTY OF National Grid SA. NO REPRODUCTION IN FULL OR IN PART SHALL BE OBTAINED FROM THIS DOCUMENT WITHOUT THE WRITTEN CONSENT OF ITS OWNER.

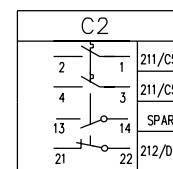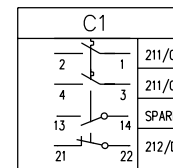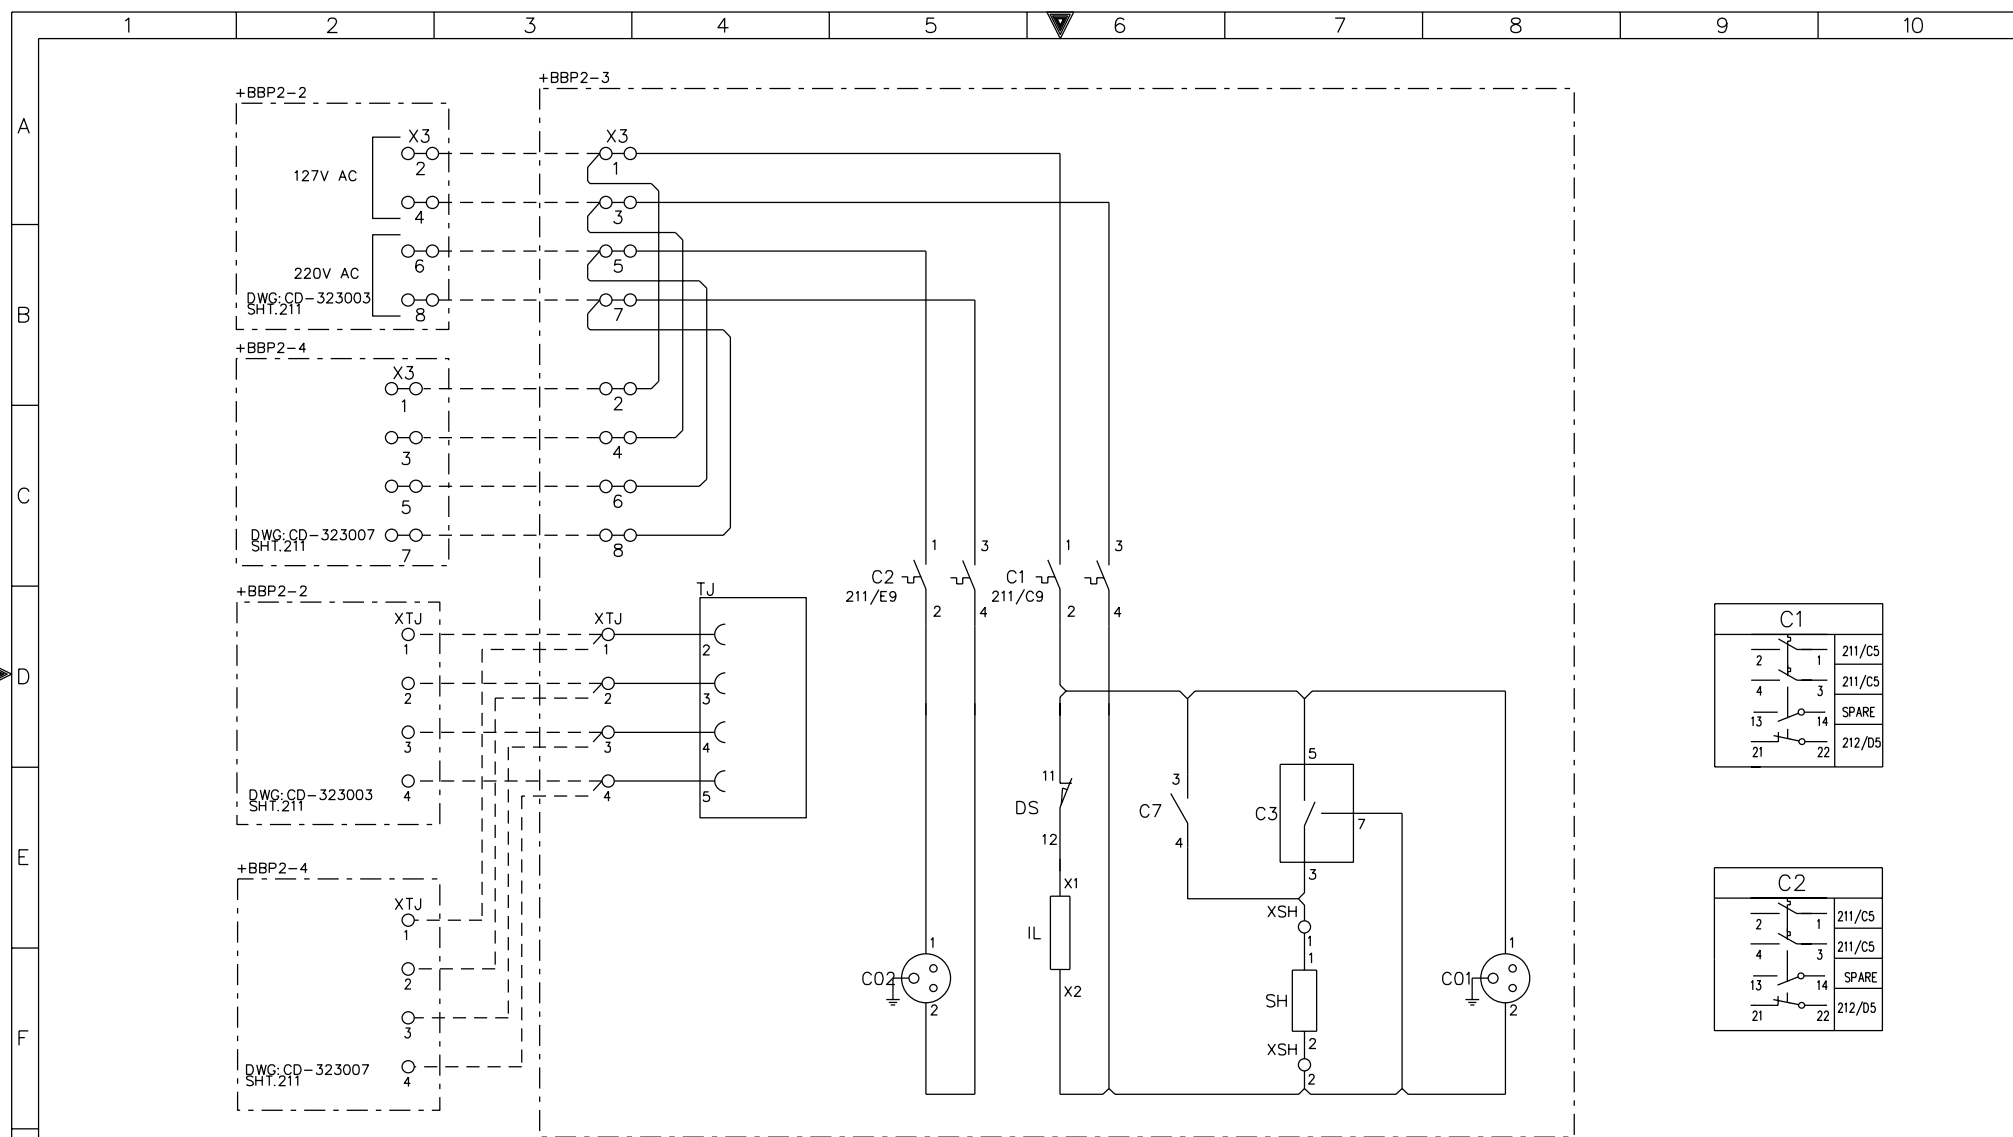




G

AS-BUILT BY _____ DATE _____			CONTRACT NO. 11131113/00		JOB ORDER NO. S-13656		AC SUPPLY FOR ILLUMINATION &POWER SOCKET				<div><div>الشركة الوطنية لنقل الكهرباء</div><div><div>نقل الكهرباء</div><div>National Grid sa</div></div></div>								
			DRAWN BY RIZ		CHECKED BY KVR		132KV BUSBAR PROTN.MAIN-2 BU PANEL +BBP2-3												
01 13 49			FACTORY ASBUILT		DATE STARTED 30.01.2013		DATE COMPLETED _____		S/S 8709 - 132/13.8KV IN AL-KHARJ CITY				INDEX	PLANT NO.	DRAWING NUMBER		SHEET NO.		REV. NO.
00 13 05			FOR APPROVAL						RIYADH SAUDI ARABIA				-	C421	CD-323005		211 212		01
REV. NO.			DATE		DESCRIPTION		OPRG. DEPT. CTPD		ENG. DEPT. AUT-PSAC										

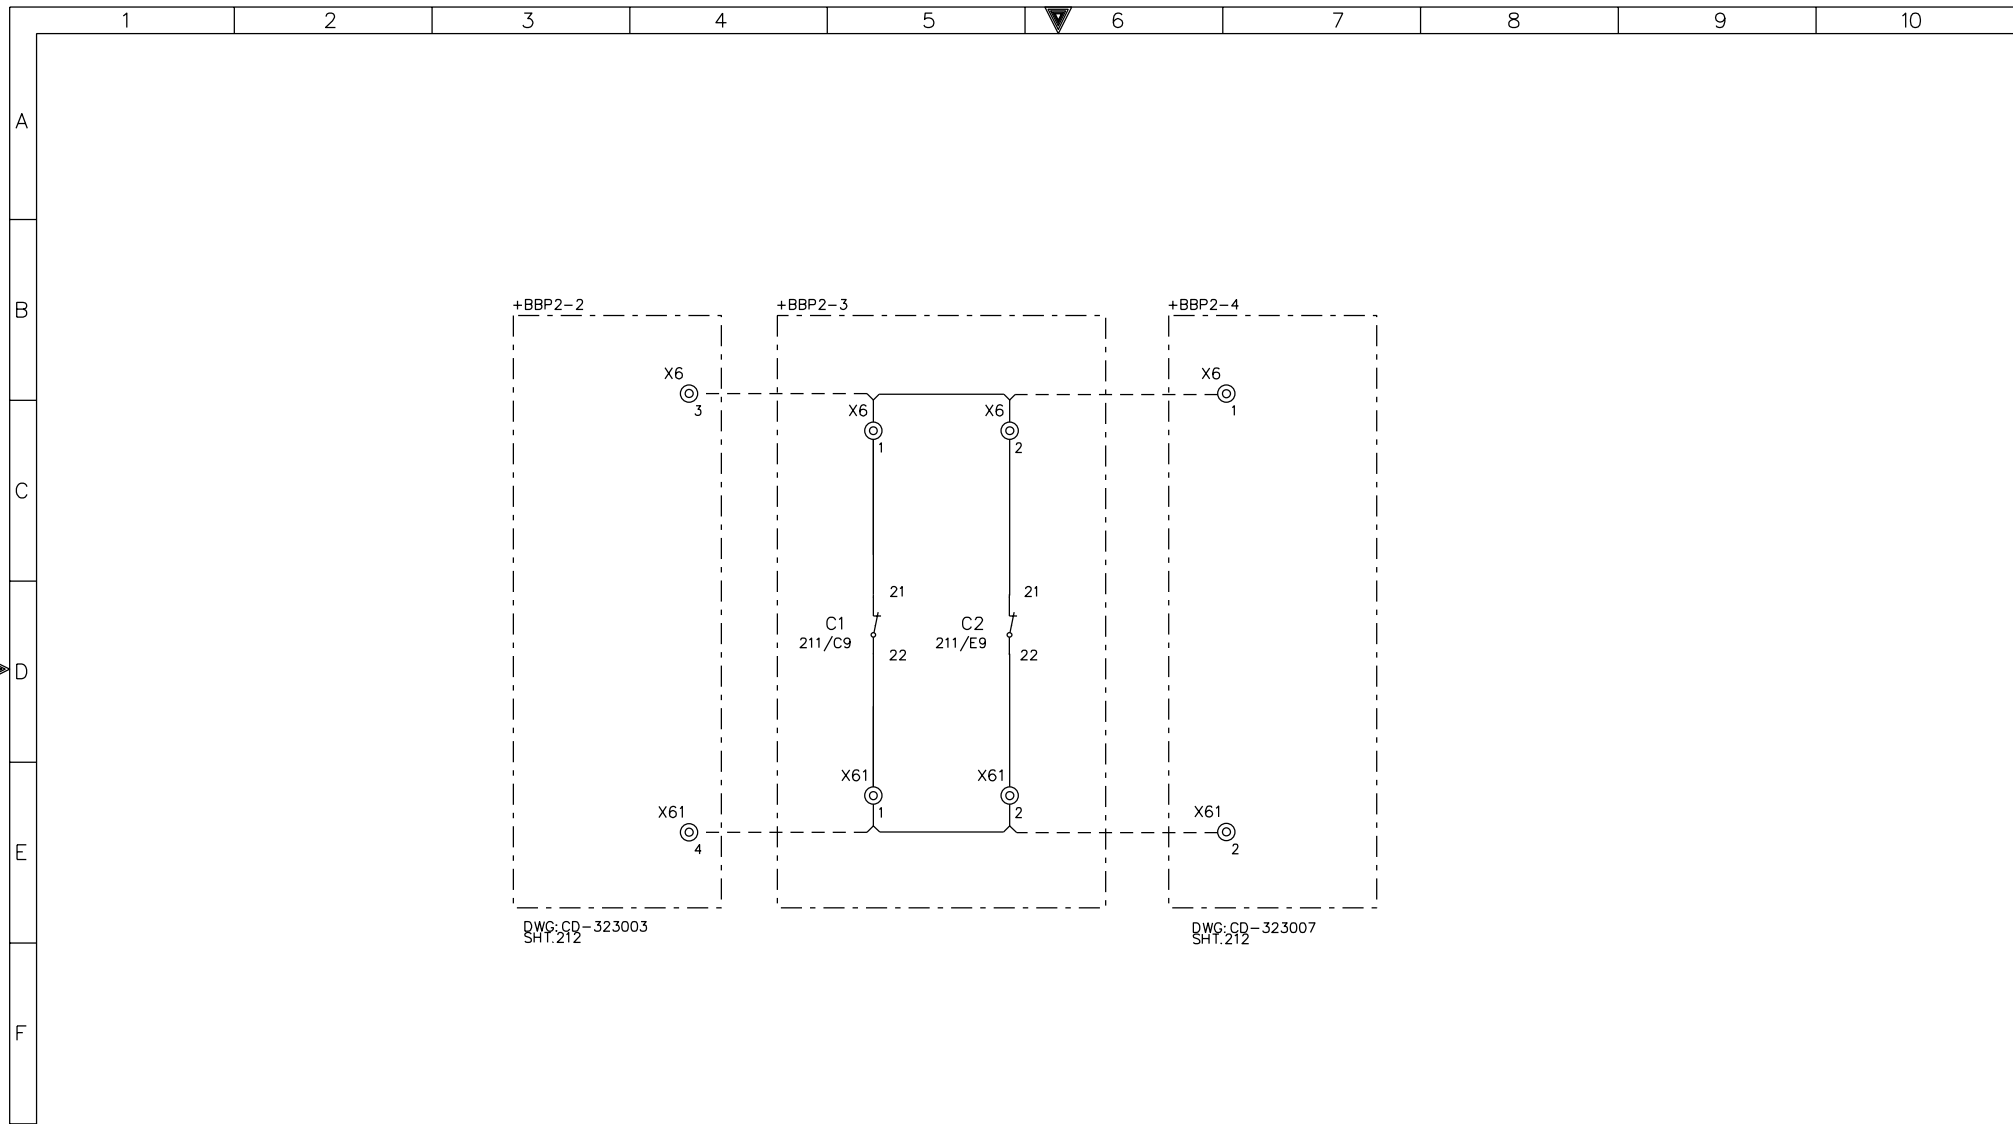


AS-BUILT BY _____ DATE _____			CONTRACT NO. 11131113/00		JOB ORDER NO. S-13656		CUB.LIGHTING,HEATER&SOKET ALARM CKT.			
01	13 49	FACTORY ASBUILT	DRAWN BY RIZ		CHECKED BY KVR		132KV BUSBAR PROTN.MAIN-2 BU PANEL +BBP2-3			
00	13 05	FOR APPROVAL	DATE STARTED 30.01.2013		DATE COMPLETED		S/S 8709 - 132/13.8KV IN AL-KHARJ CITY			
REV. NO.	DATE	DESCRIPTION	OPRG. DEPT. CTPD		ENG. DEPT. AUT-PSAC		INDEX	PLANT NO.	DRAWING NUMBER	SHEET NO.
							-	C421	CD-323005	SHT CONT.
										212 216
										01


THIS DRAWING AND THE INFORMATION CONTAINED HEREIN ARE THE SOLE PROPERTY OF National Grid SA. NO REPRODUCTION IN FULL OR IN PART SHALL BE OBTAINED FROM THIS DOCUMENT WITHOUT THE WRITTEN CONSENT OF ITS OWNER.

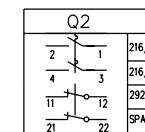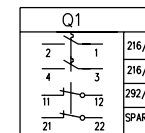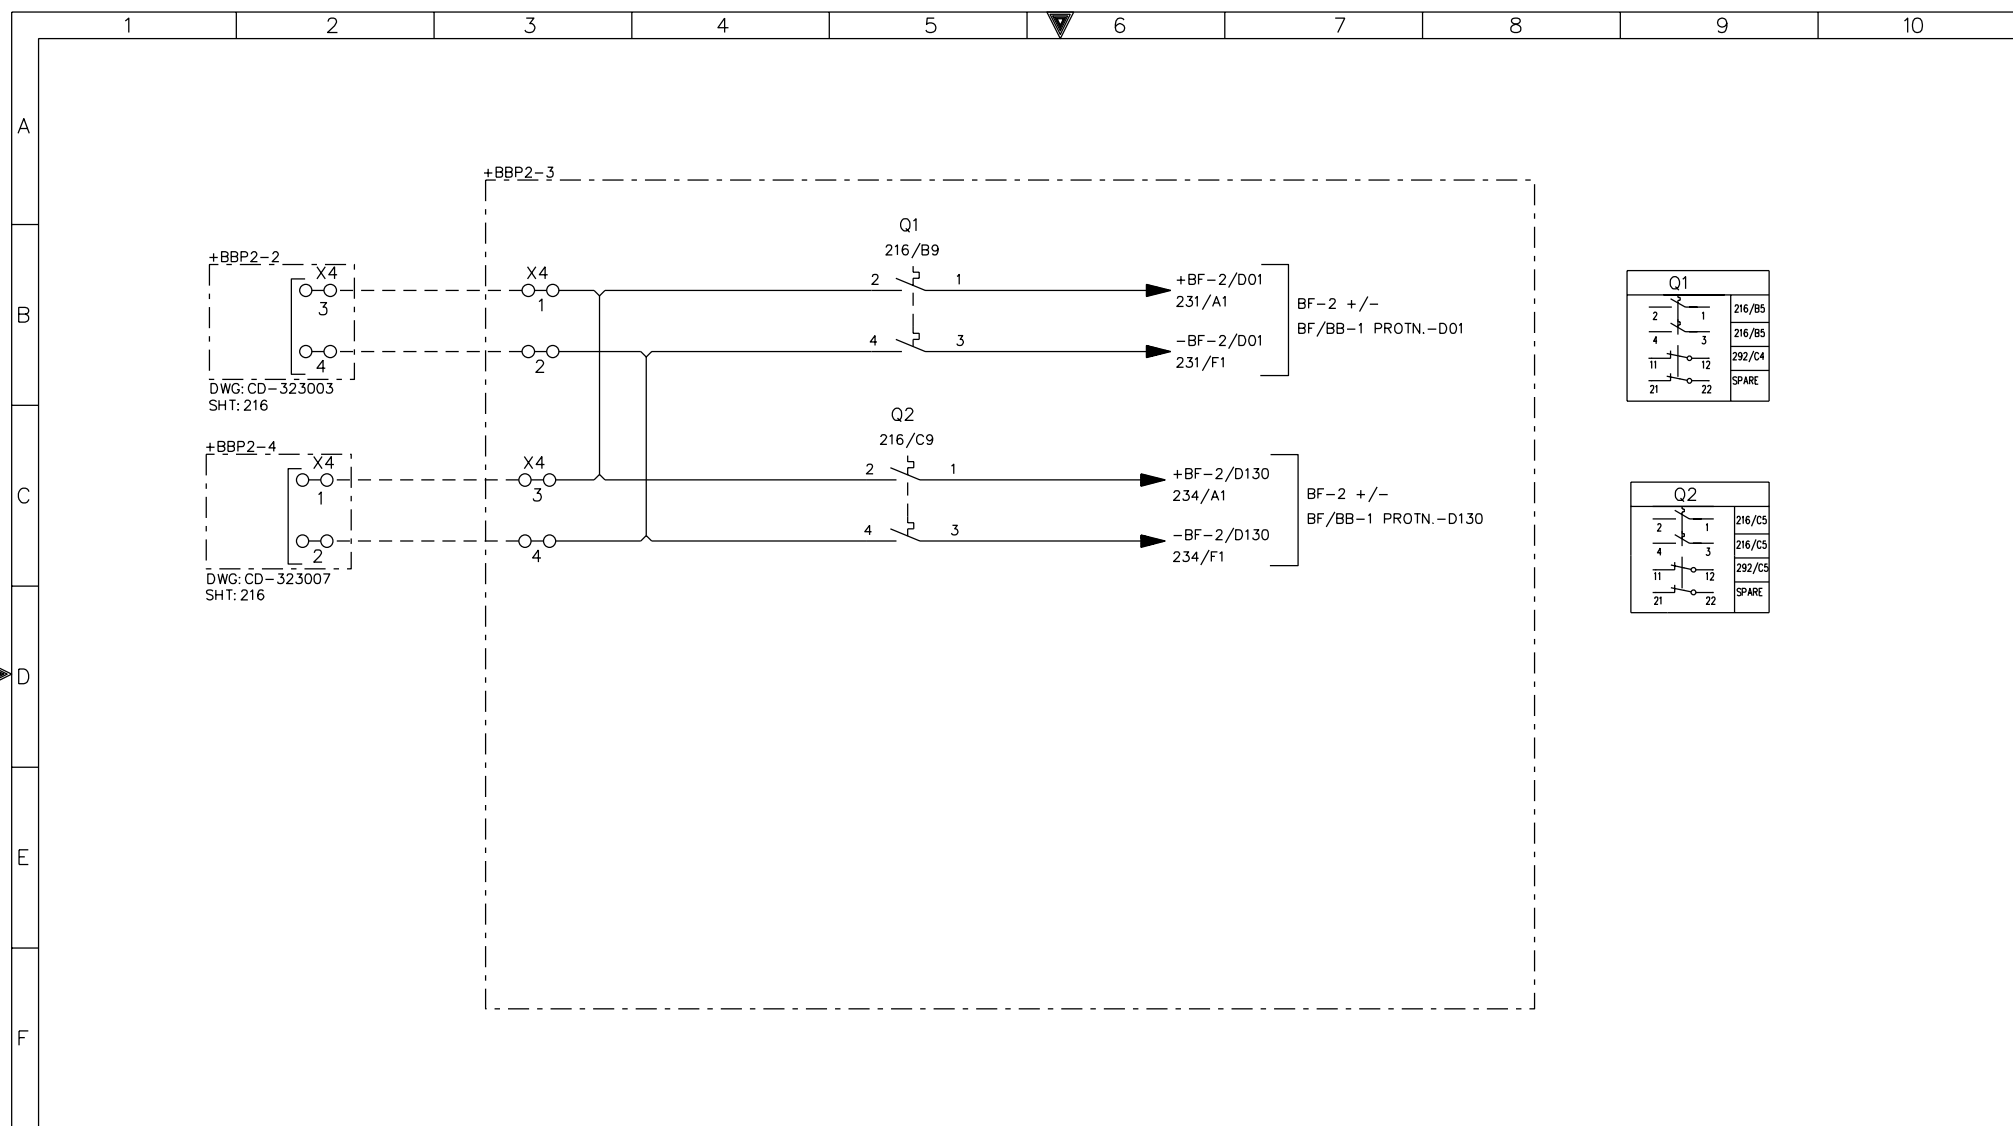

AS-BUILT BY _____ DATE _____			CONTRACT NO. 11131113/00		JOB ORDER NO. S-13656		DC SUPPLY DISTRIBUTION			الشركة الوطنية لنقل الكهرباء National Grid sa			
01	13 49	FACTORY ASBUILT	DRAWN BY RIZ		CHECKED BY KVR		132KV BUSBAR PROTN.MAIN-2 BU PANEL +BBP2-3			INDEX	PLANT NO.	DRAWING NUMBER	SHEET NO.
00	13 05	FOR APPROVAL	DATE STARTED 30.01.2013		DATE COMPLETED		S/S 8709 - 132/13.8KV IN AL-KHARJ CITY			-	C421	CD-323005	SHT CONT.
REV. NO.	DATE	DESCRIPTION	OPRG. DEPT. CTPD		ENG. DEPT. AUT-PSAC		RIYADH SAUDI ARABIA			216 221 01			

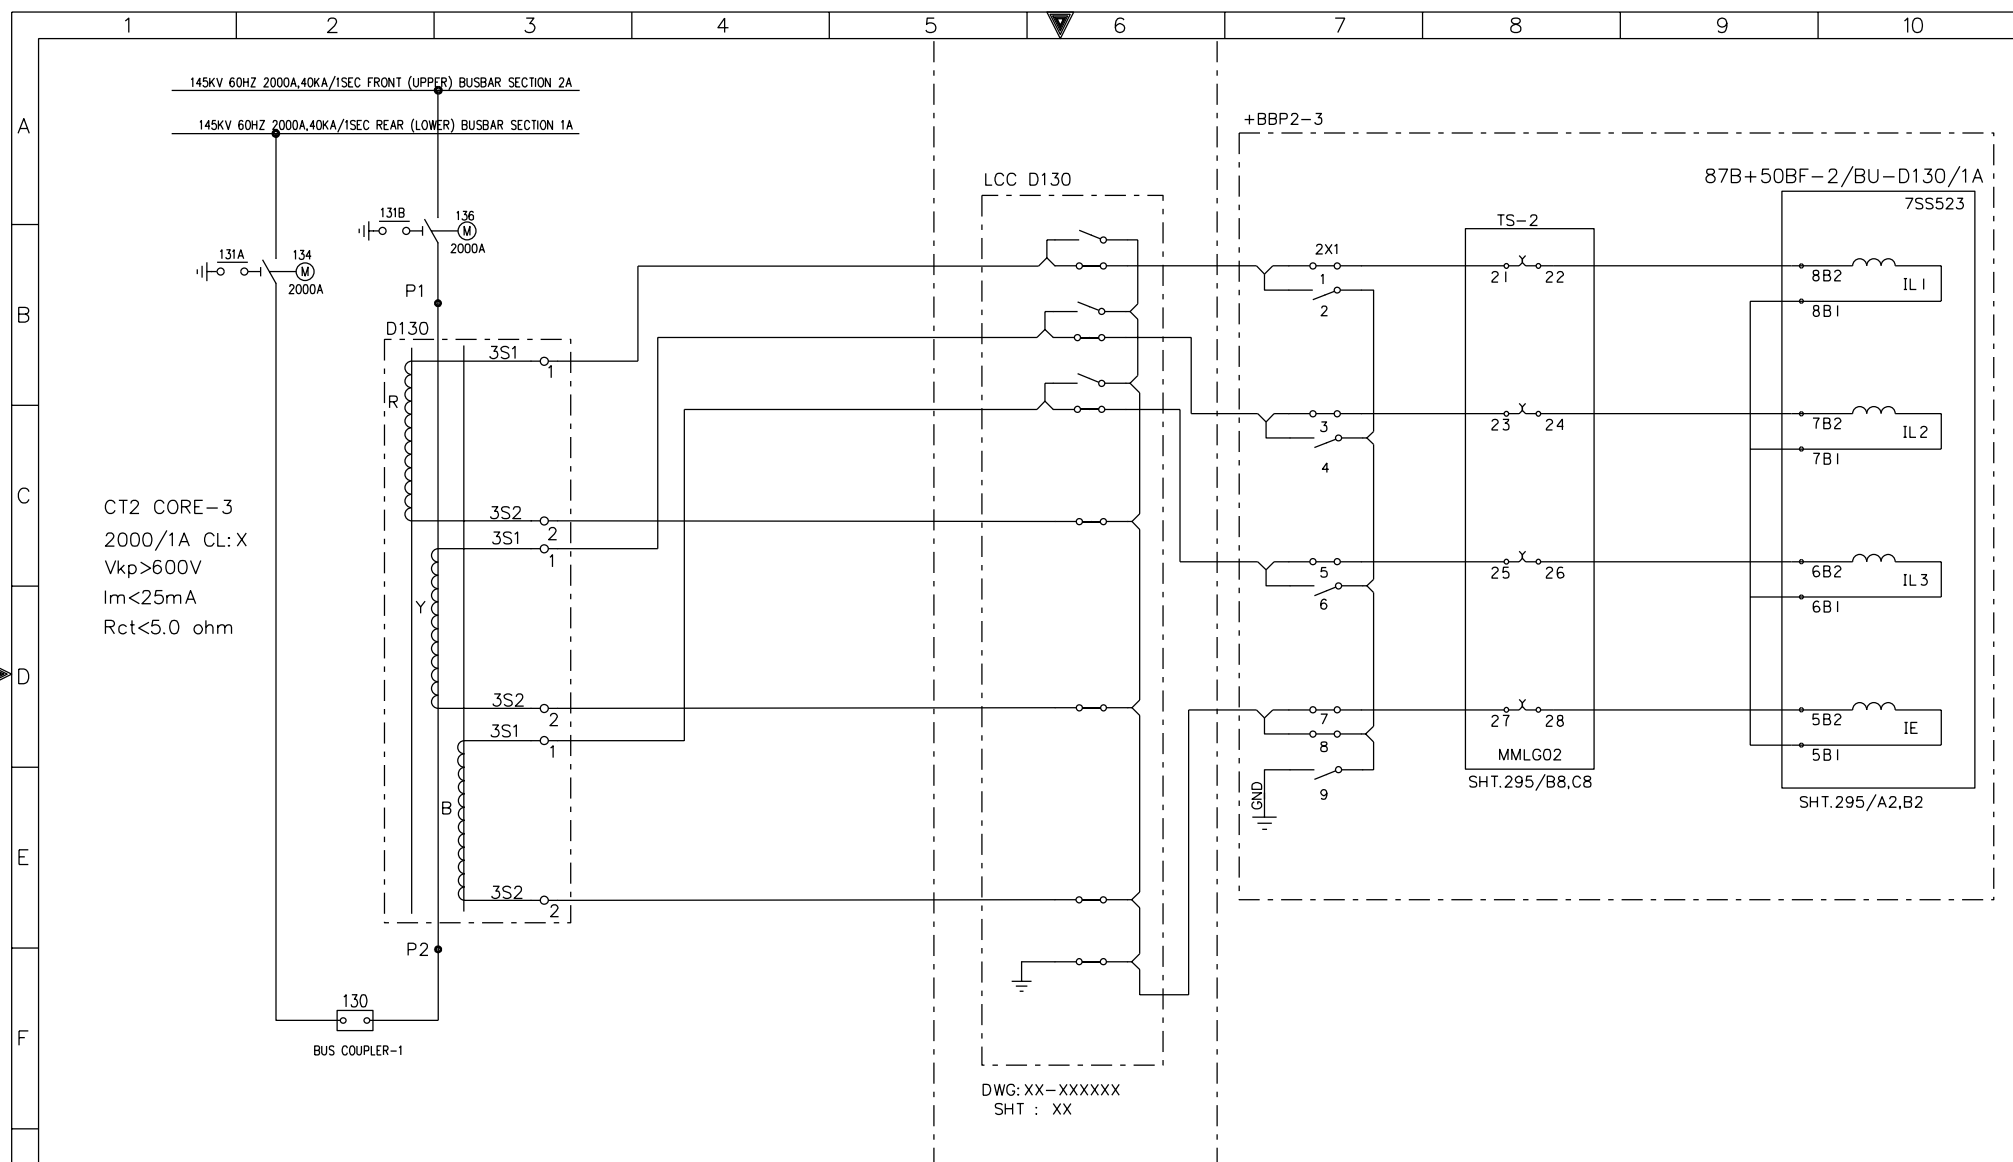

AS-BUILT BY _____ DATE _____		CONTRACT NO. 11131113/00	JOB ORDER NO. S-13656	CURRENT TRANSFORMER INPUTS -87B+50BF-2/BU-D130/1A	الشركة الوطنية لنقل الكهرباء National Grid SA			
01	13 49	FACTORY ASBUILT	DRAWN BY RIZ CHECKED BY KVR	132KV BUSBAR PROTN,MAIN-2 BU PANEL +BBP2-3	INDEX	PLANT NO.	DRAWING NUMBER	SHEET NO.
00	13 05	FOR APPROVAL	DATE STARTED 30.01.2013 DATE COMPLETED _____	S/S 8709 - 132/13.8KV IN AL-KHARJ CITY	-	C421	CD-323005	SHT CONT.
REV. NO.	DATE	DESCRIPTION	OPRG. DEPT. CTPD ENG. DEPT. AUT-PSAC	RIYADH SAUDI ARABIA				222
								223
								01

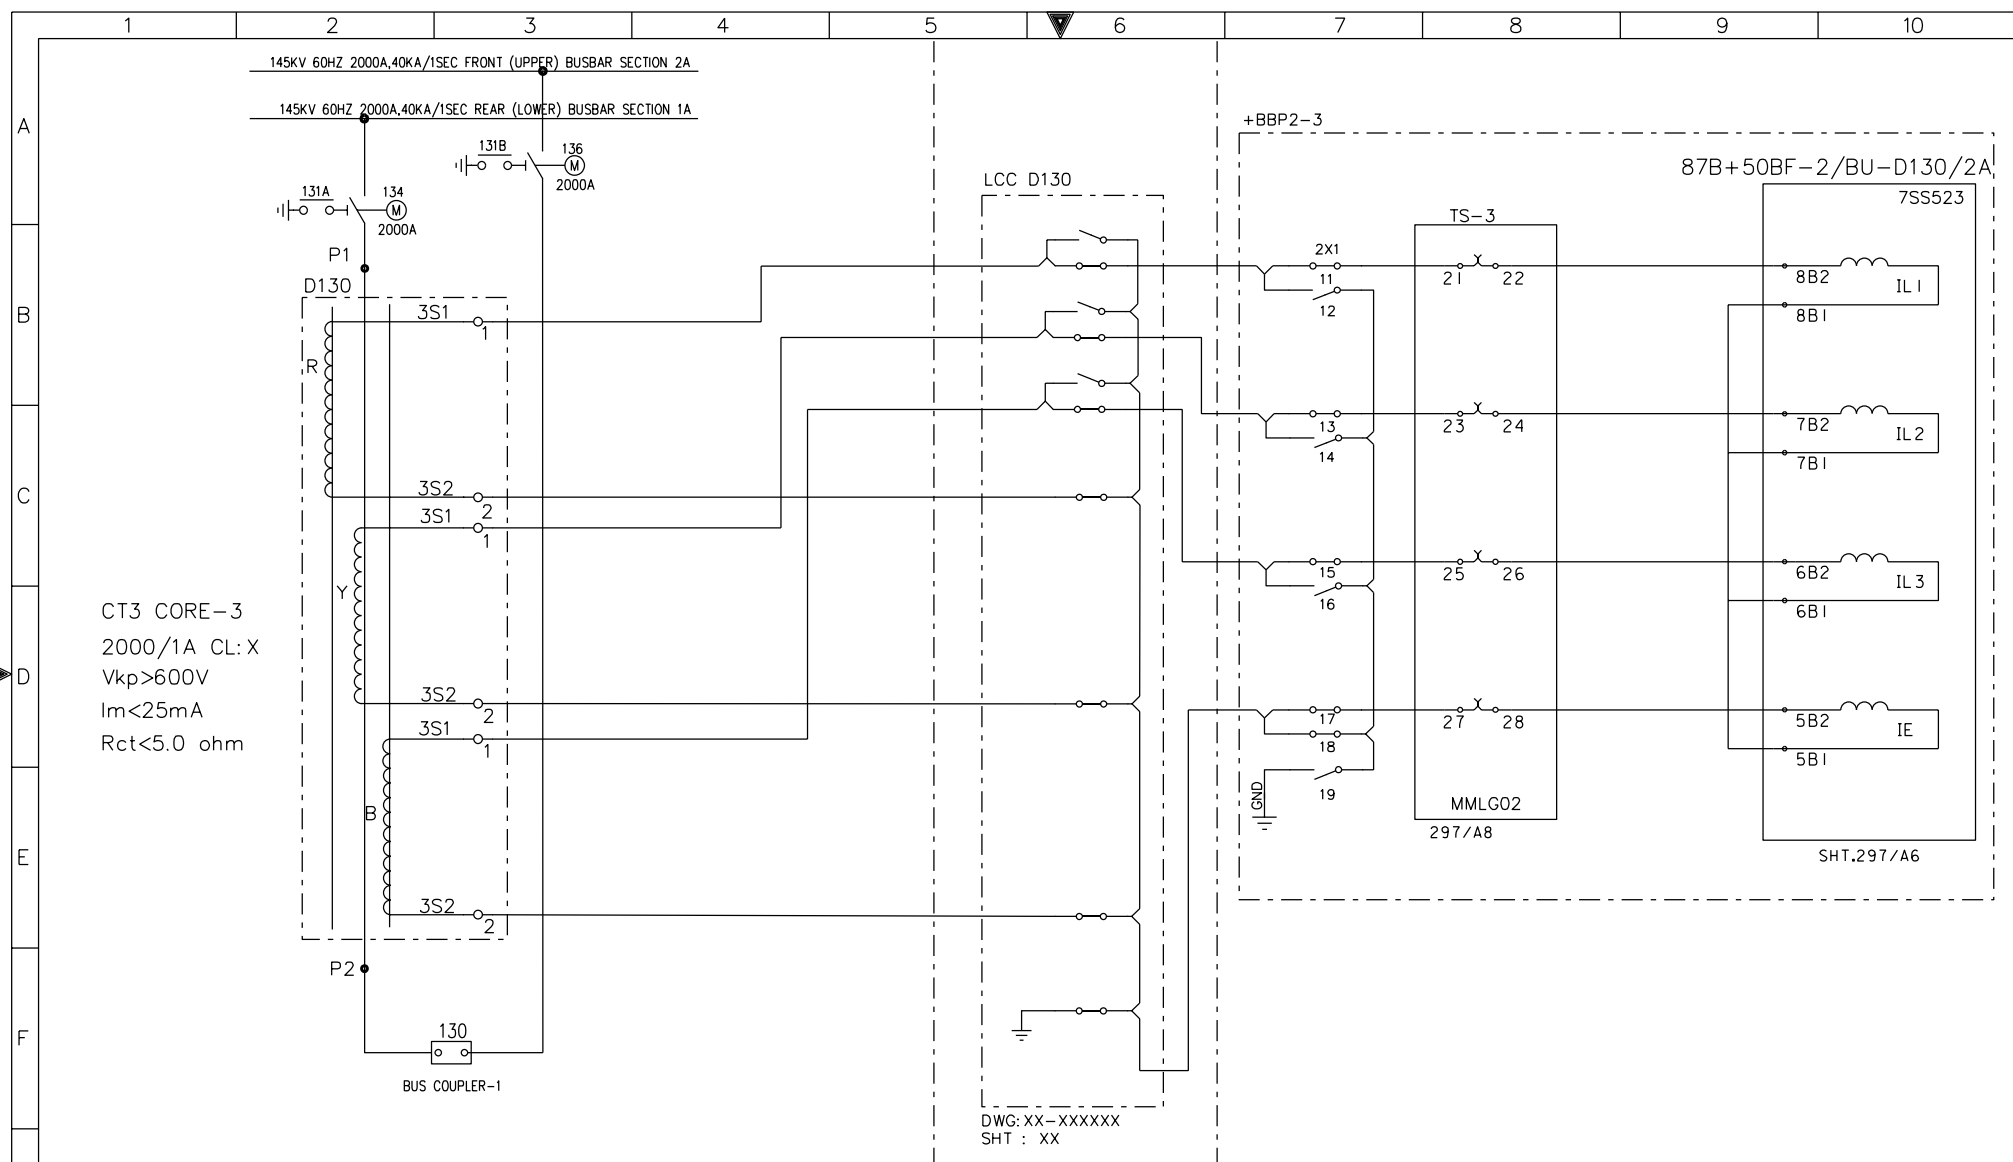

AS-BUILT BY

DATE

CONTRACT NO.

11131113/00

JOB ORDER NO.

S-13656

01

13 49

FACTORY ASBUILT

00

13 05

FOR APPROVAL

REV. NO.

DATE

DESCRIPTION

DRAWN BY

RIZ

CHECKED BY

KVR

DATE STARTED

30.01.2013

DATE COMPLETED

OPRG. DEPT.

CTPD

ENG. DEPT.

AUT-PSAC

CURRENT TRANSFORMER INPUTS

-87B+50BF-2/BU-D130/2A

132KV BUSBAR PROTN,MAIN-2 BU PANEL


+BBP2-3

S/S 8709 - 132/13.8KV IN AL-KHARJ CITY

RIYADH

SAUDI ARABIA

الشركة الوطنية لنقل الكهرباء



National Grid SA

INDEX

PLANT NO.

DRAWING NUMBER

SHEET NO.

REV. NO.


-

C421

CD-323005


223/231


01

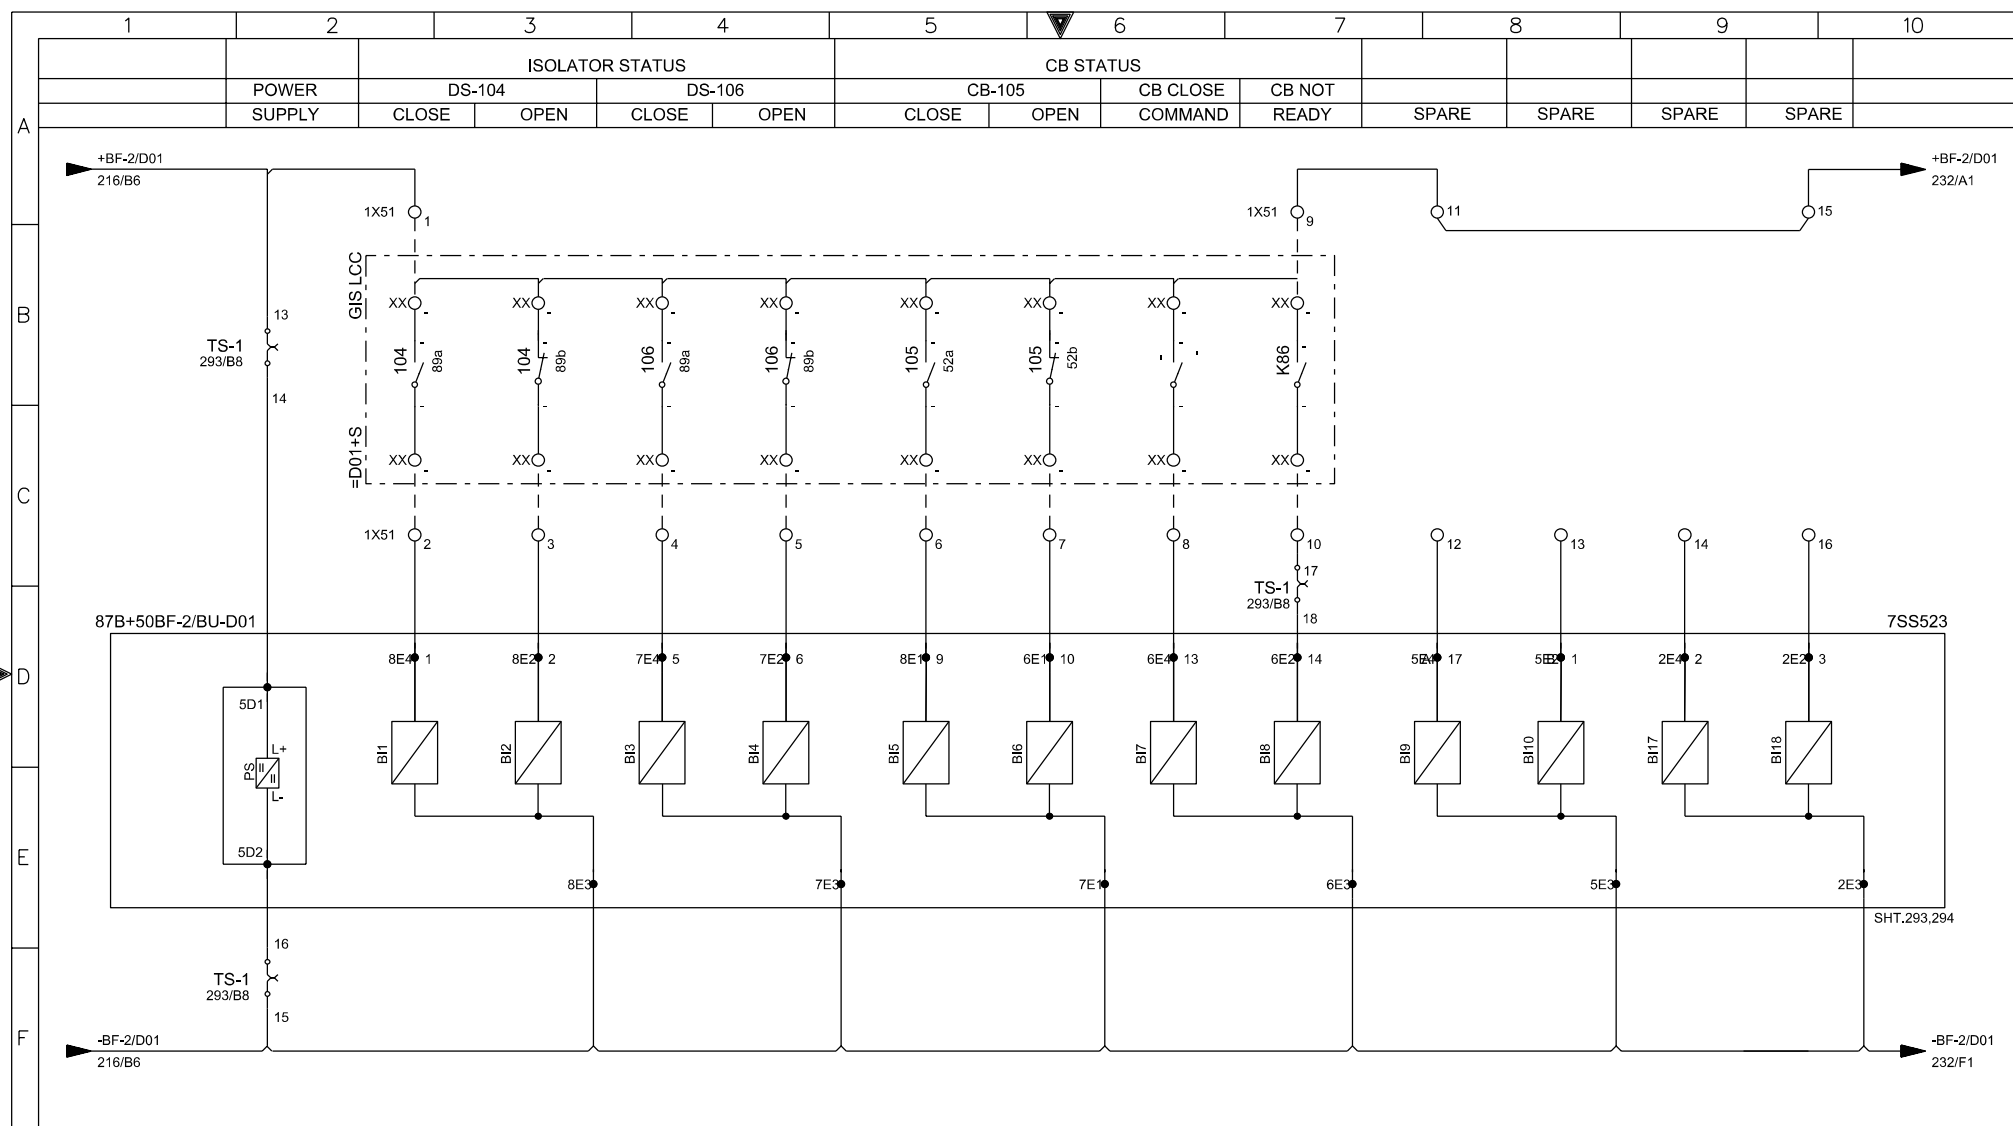

G

AS-BUILT BY _____		DATE _____	CONTRACT NO. 11131113/00		JOB ORDER NO. S-13656		87B+50BF-2/BU-D01 PROTN.RELAY - BINARY INPUTS		<div><div>الشركة الوطنية لنقل الكهرباء</div><div></div><div>National Grid SA</div></div>						
01	13 49	FACTORY ASBUILT		DRAWN BY RIZ		CHECKED BY KVR	132KV BUSBAR PROTN.MAIN-2 BU PANEL +BBP2-3								
00	13 05	FOR APPROVAL		DATE STARTED 30.01.2013		DATE COMPLETED _____	S/S 8709 - 132/13.8KV IN AL-KHARJ CITY								
REV. NO.	DATE	DESCRIPTION		OPRG. DEPT. CTPD		ENG. DEPT. AUT-PSAC	RIYADH SAUDI ARABIA		INDEX -	PLANT NO. C421	DRAWING NUMBER CD-323005		SHEET NO. 231	CONT. 232	REV. NO. 01

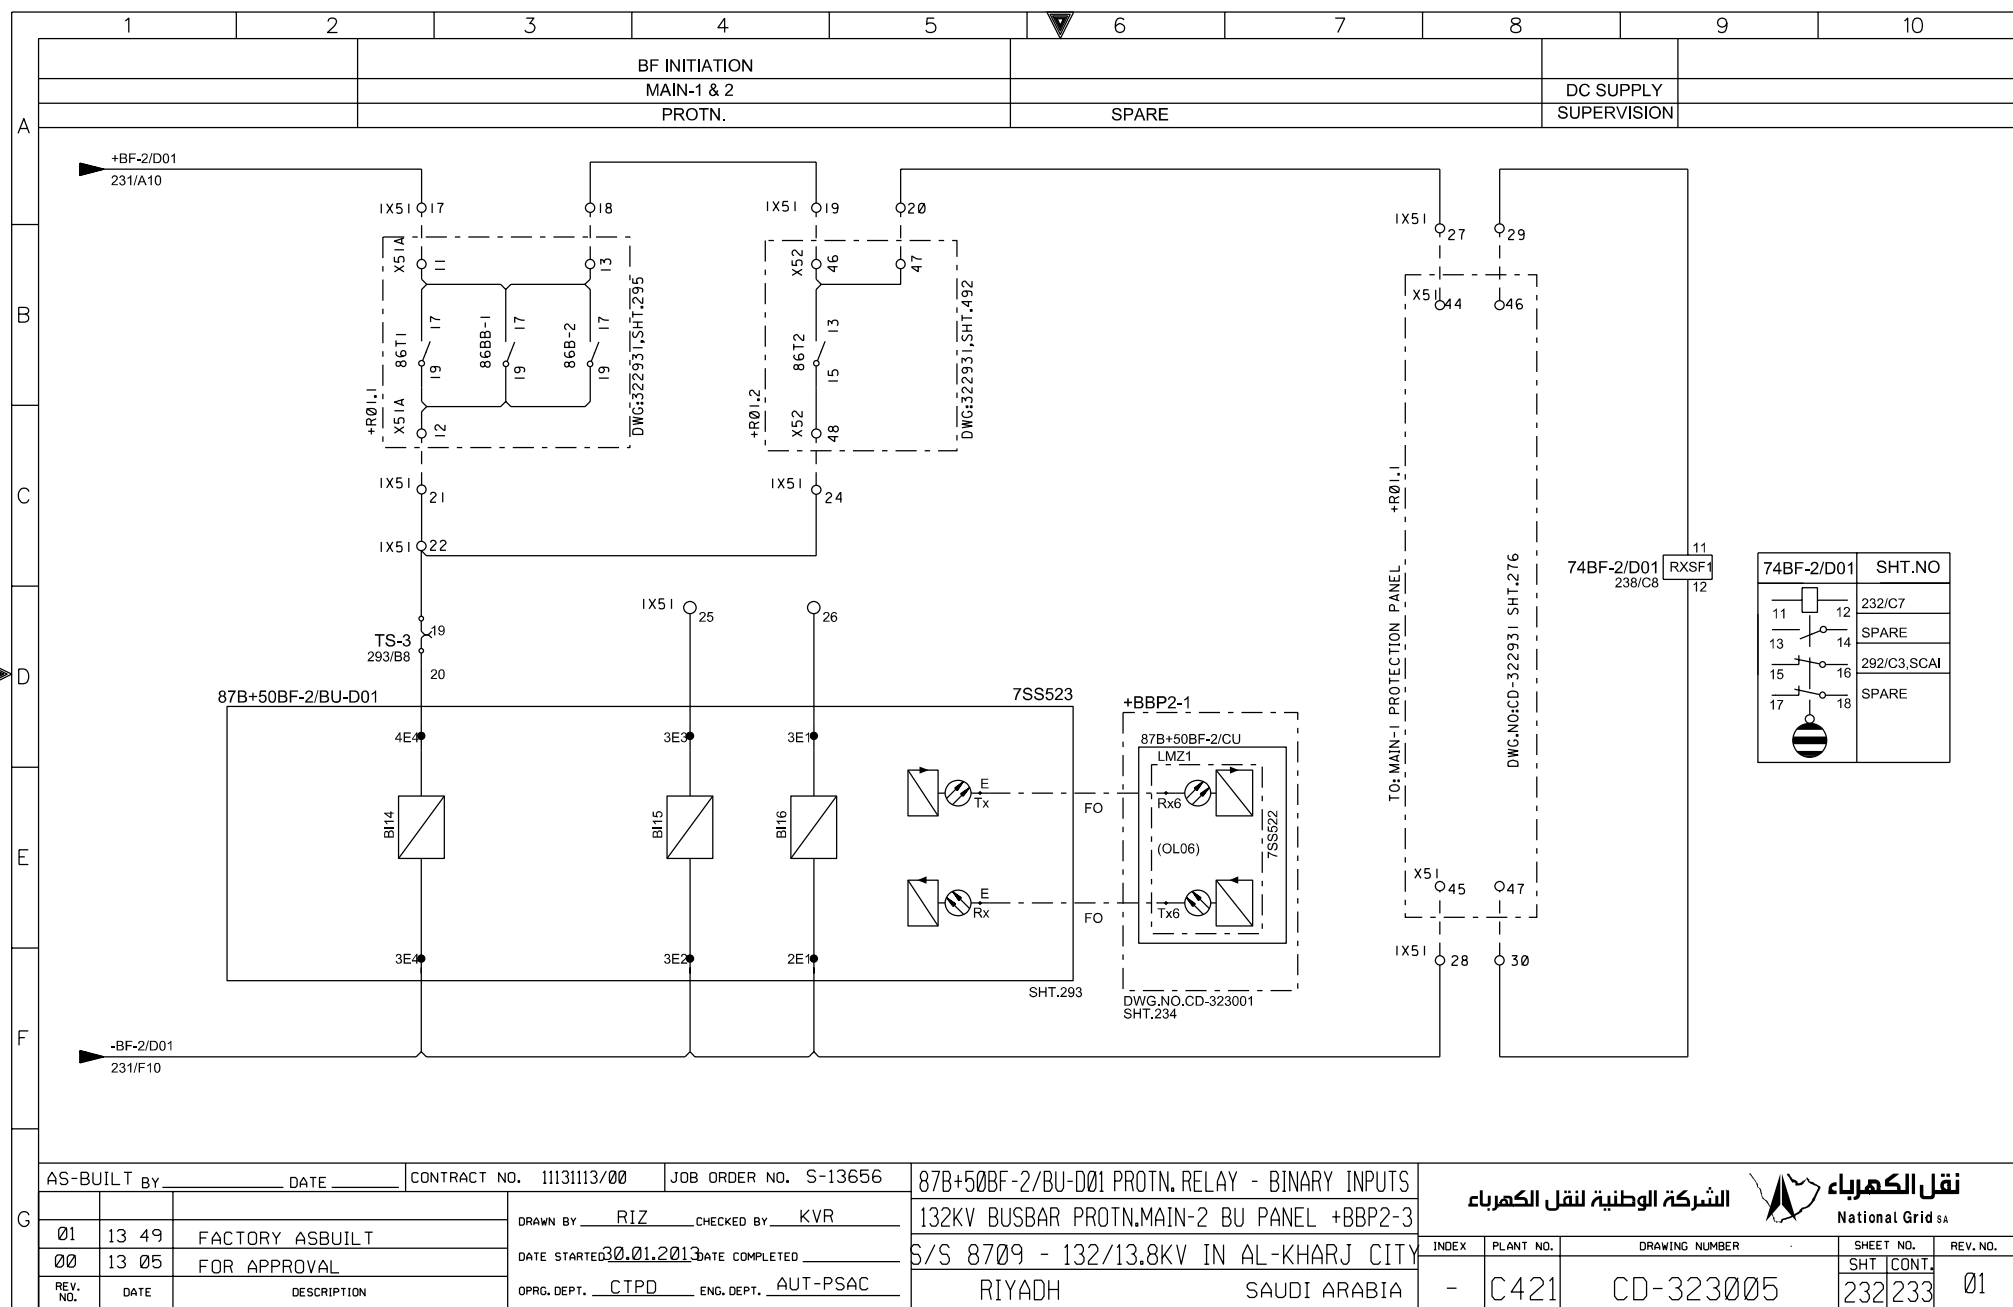

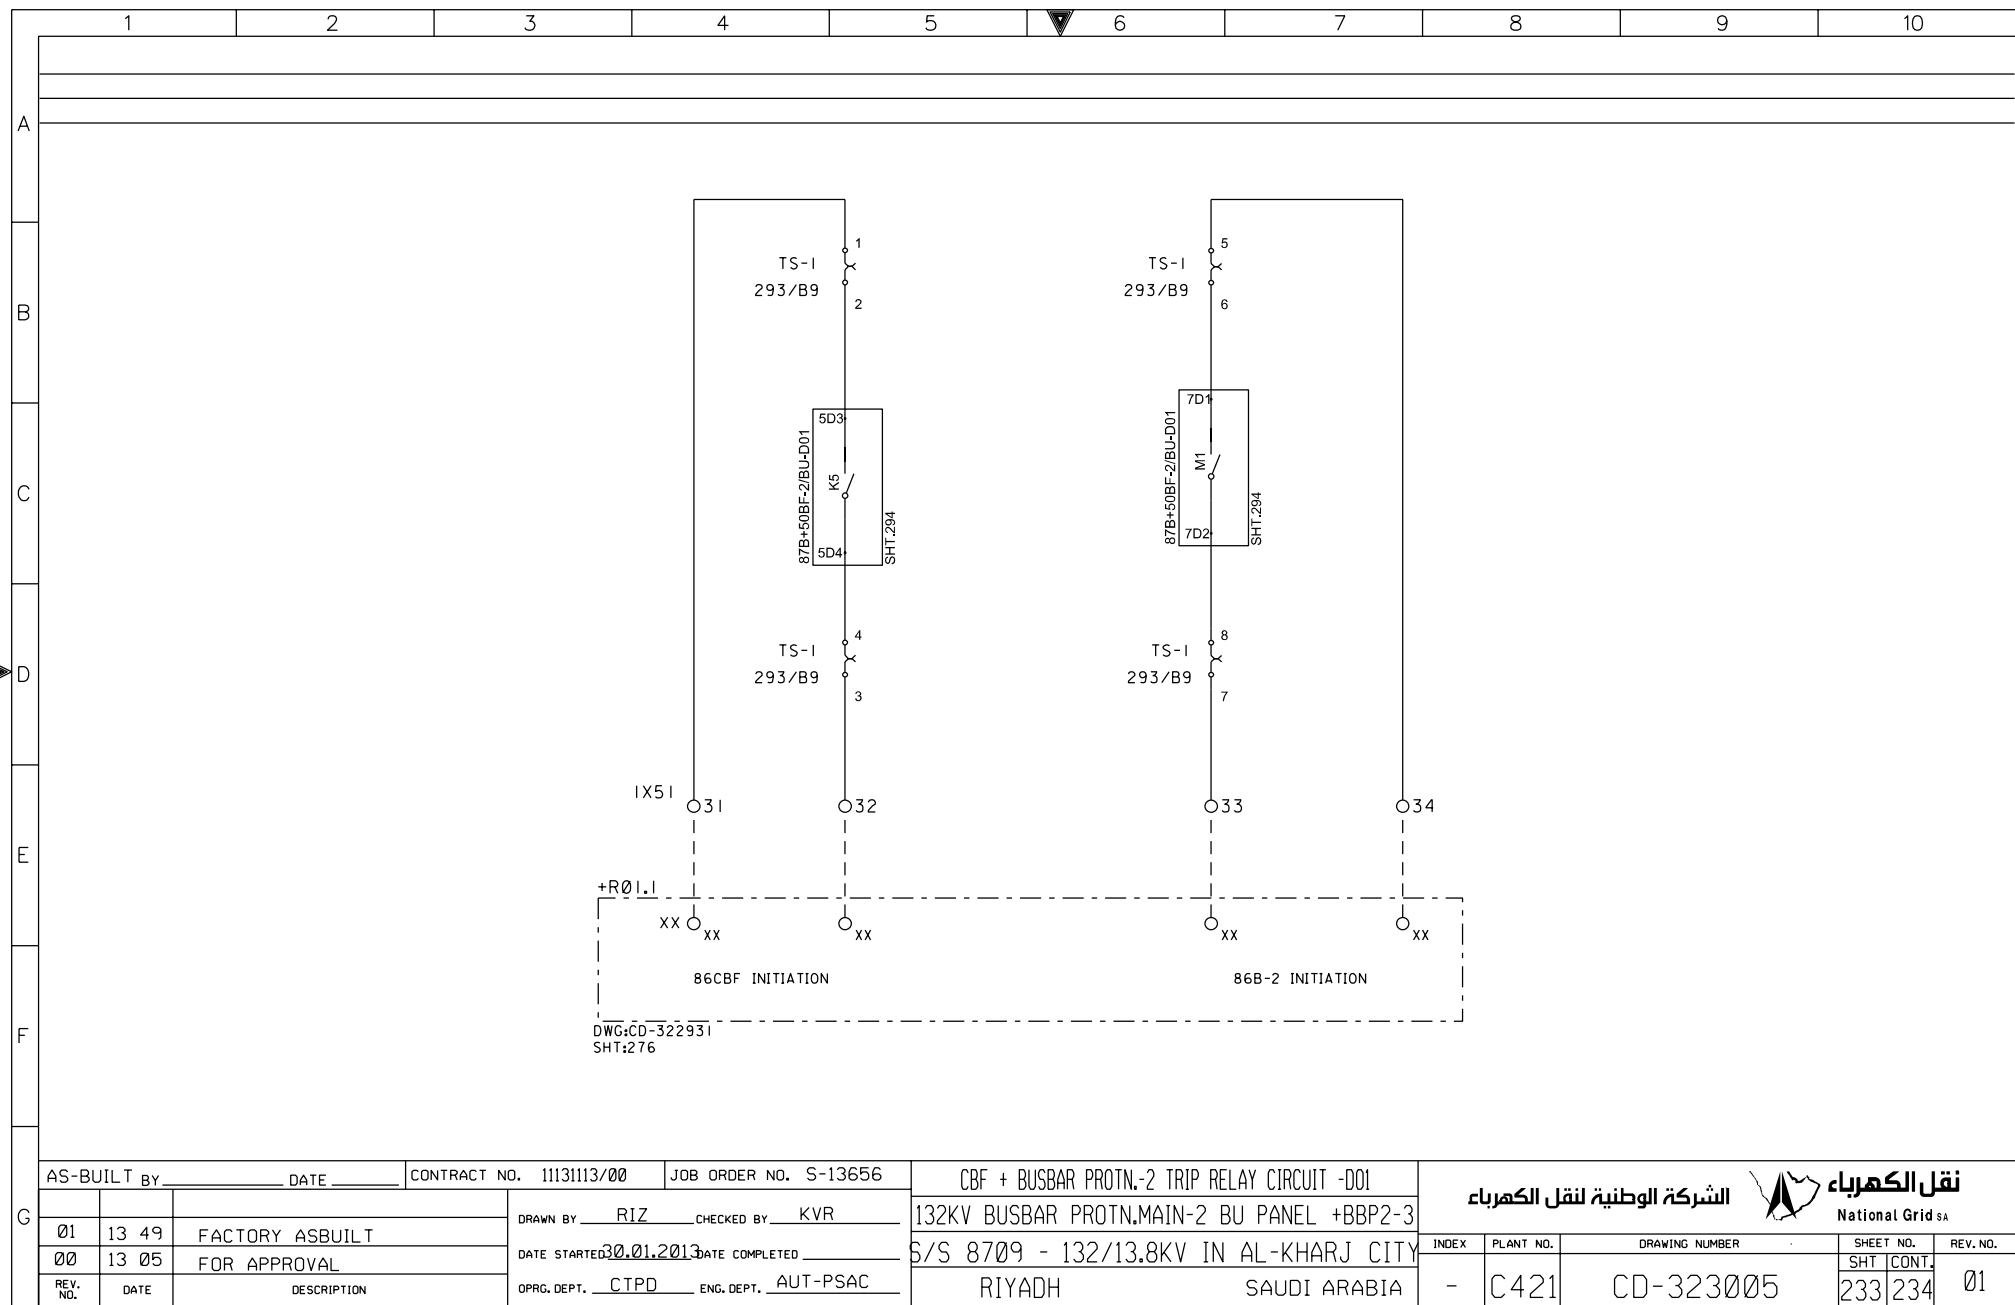

AS-BUILT BY _____ DATE _____ CONTRACT NO. 11131113/00 JOB ORDER NO. S-13656

01 13 49 FACTORY ASBUILT
00 13 05 FOR APPROVAL

DRAWN BY RIZ CHECKED BY KVR
DATE STARTED 30.01.2013 DATE COMPLETED _____
OPRG. DEPT. CTPD ENG. DEPT. AUT-PSAC

CBF + BUSBAR PROTN.-2 TRIP RELAY CIRCUIT -D01


132KV BUSBAR PROTN.MAIN-2 BU PANEL +BBP2-3
S/S 8709 - 132/13.8KV IN AL-KHARJ CITY
RIYADH SAUDI ARABIA

الشركة الوطنية لنقل الكهرباء

نقل الكهرباء
National Grid sa

INDEX	PLANT NO.	DRAWING NUMBER	SHEET NO.	REV. NO.
-	C421	CD-323005	233 234	01

NG/D2-D (2012/01)
DMS VECTOR NGD200

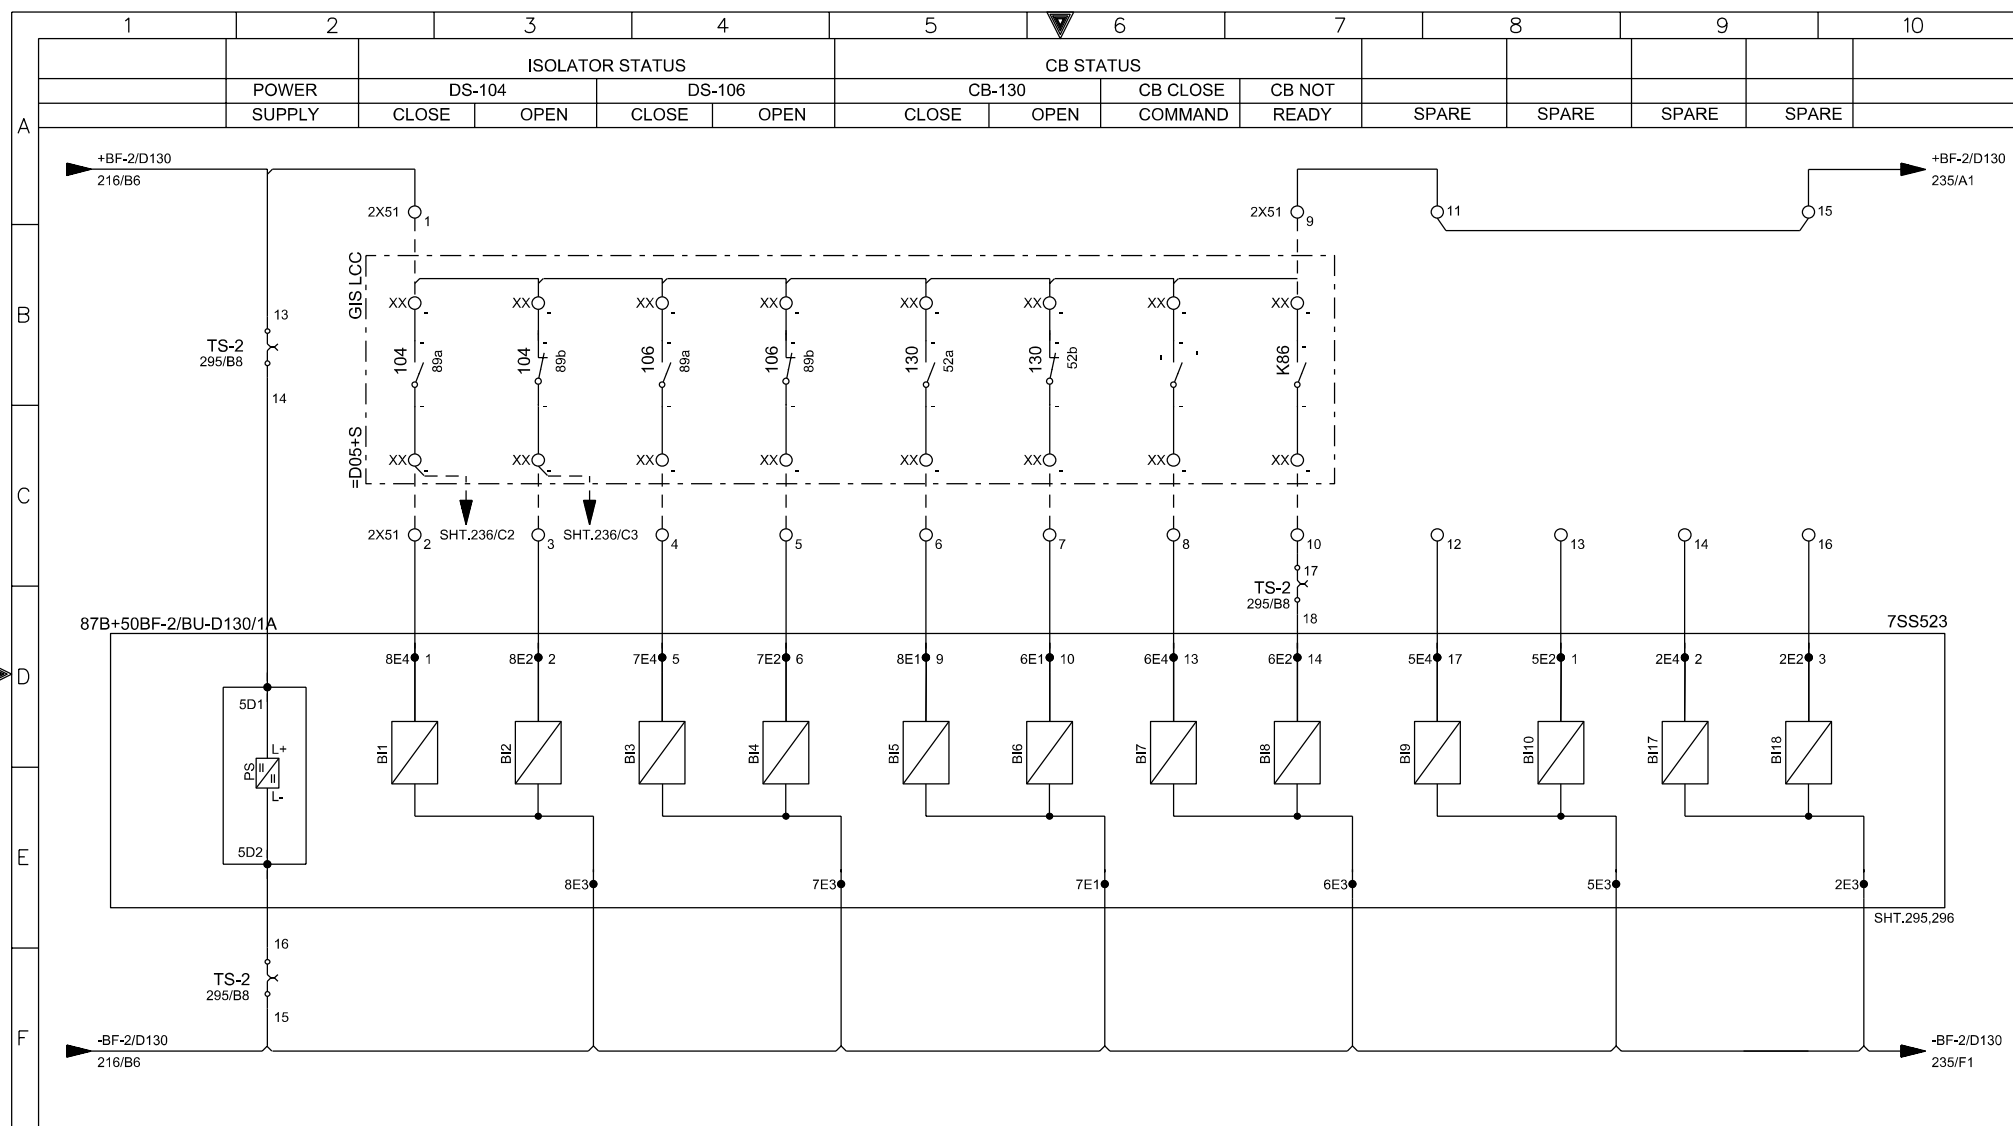

AS-BUILT BY _____ DATE _____

CONTRACT NO. 1113113/00

JOB ORDER NO. S-13656

87B+50BF-2/BU-D130/1A PROTN.RELAY - BINARY INPUTS

01

13 49

FACTORY ASBUILT

00

13 05

FOR APPROVAL

REV. NO.

DATE

DESCRIPTION

DRAWN BY RIZ

CHECKED BY KVR

DATE STARTED 30.01.2013

DATE COMPLETED _____

OPRG. DEPT. CTPD

ENG. DEPT. AUT-PSAC

132KV BUSBAR PROTN.MAIN-2 BU PANEL +BBP2-3

S/S 8709 - 132/13.8KV IN AL-KHARJ CITY

RIYADH


SAUDI ARABIA

الشركة الوطنية لنقل الكهرباء



National Grid SA

INDEX	PLANT NO.	DRAWING NUMBER	SHEET NO.	REV. NO.
			SHT	CONT.
-	C421	CD-323005	234	235
				01

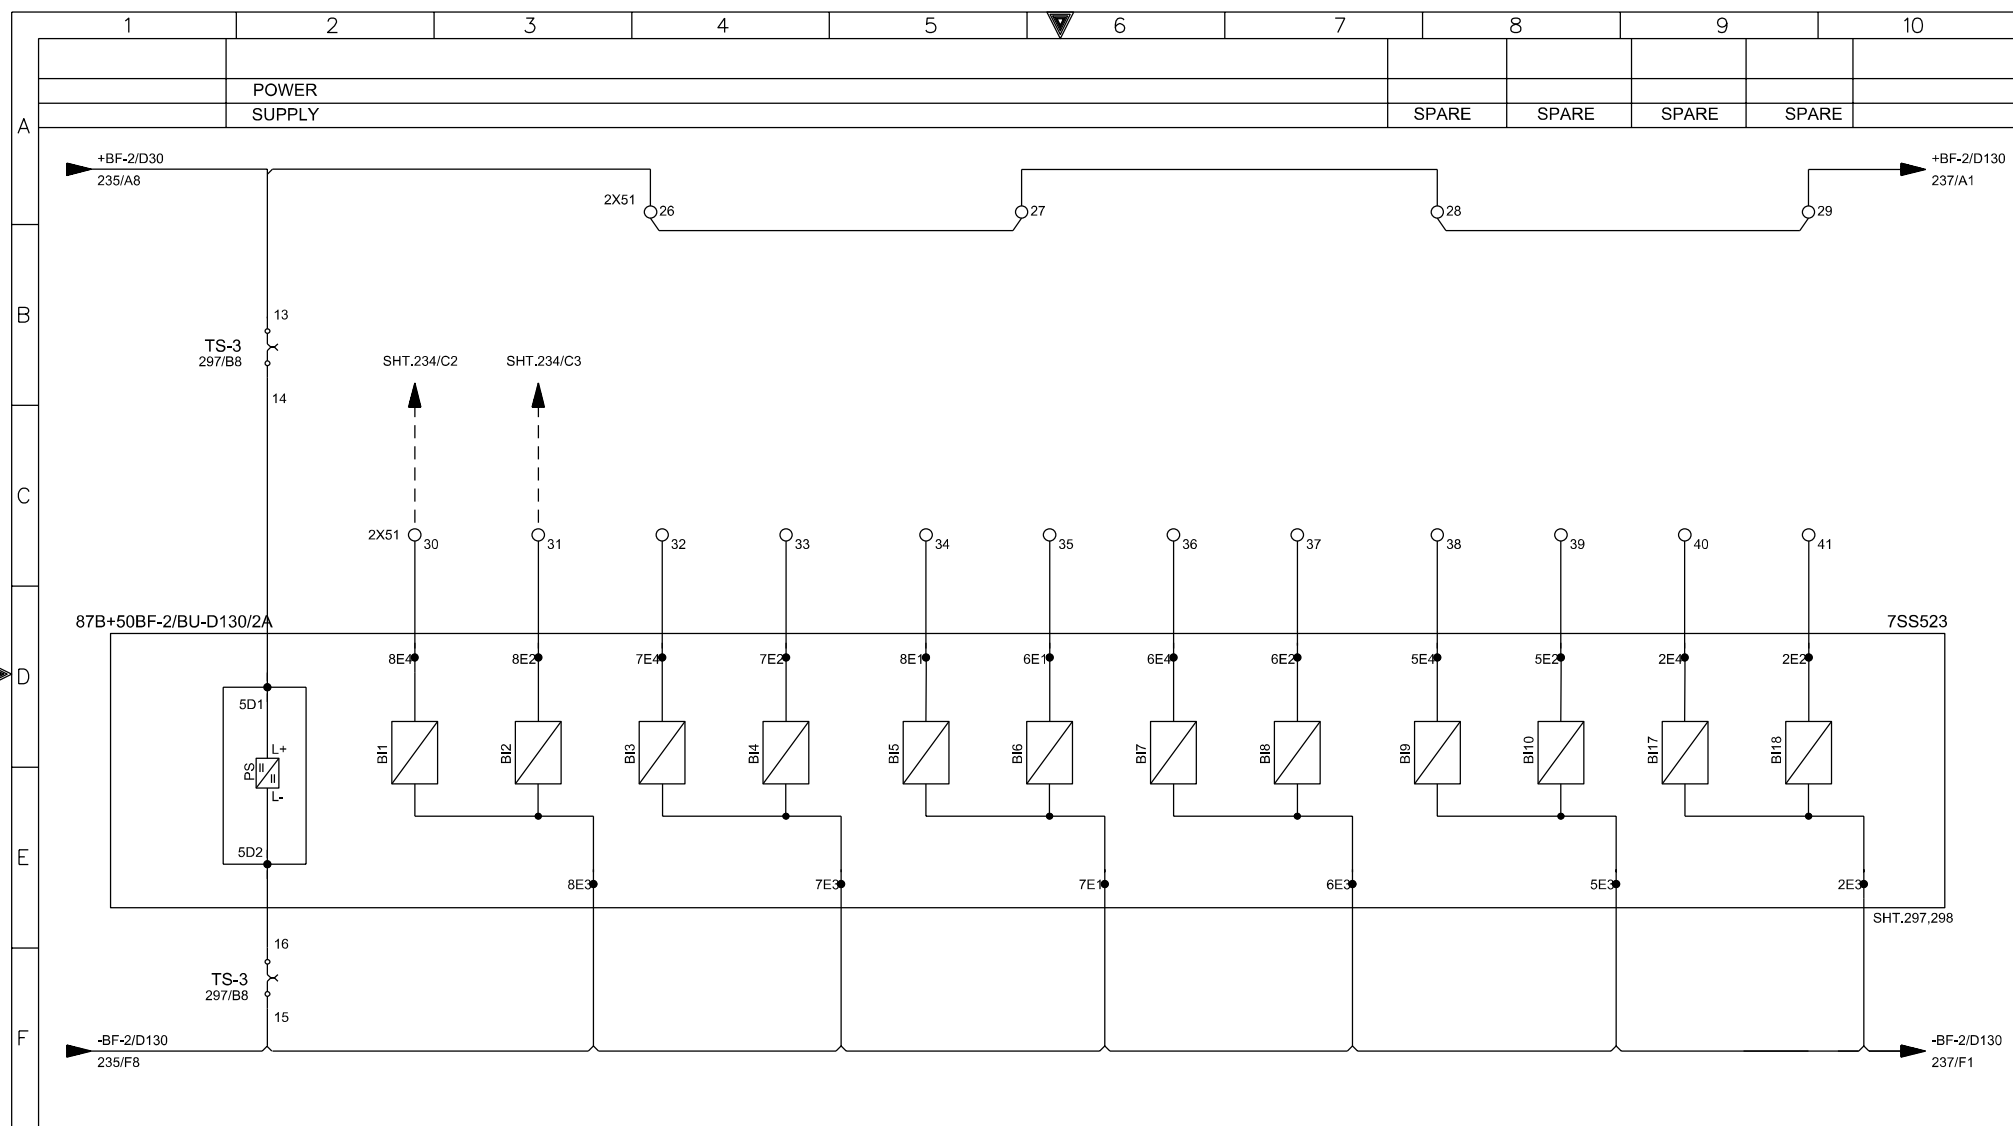

AS-BUILT BY

DATE

CONTRACT NO.

11131113/00

JOB ORDER NO.

S-13656

01

13 49

FACTORY ASBUILT

00

13 05

FOR APPROVAL

REV. NO.

DATE

DESCRIPTION

DRAWN BY

RIZ

CHECKED BY

KVR

DATE STARTED

30.01.2013

DATE COMPLETED

OPRG. DEPT.

CTPD

ENG. DEPT.

AUT-PSAC


87B+50BF-2/BU-D130/2A PROTN.RELAY - BINARY INPUTS

132KV BUSBAR PROTN.MAIN-2 BU PANEL +BBP2-3

S/S 8709 - 132/13.8KV IN AL-KHARJ CITY

RIYADH SAUDI ARABIA

الشركة الوطنية لنقل الكهرباء



National Grid sa

INDEX

PLANT NO.

DRAWING NUMBER

SHEET NO.

SHT

CONT.

REV.NO.

-

C421



CD-323005

236


237

01


THIS DRAWING AND THE INFORMATION CONTAINED HEREIN ARE THE SOLE PROPERTY OF NATIONAL GRID SA. NO REPRODUCTION IN FULL OR IN PART SHALL BE OBTAINED FROM THIS DOCUMENT WITHOUT THE WRITTEN CONSENT OF ITS OWNER.

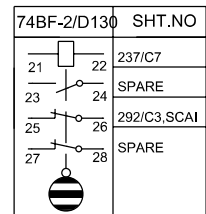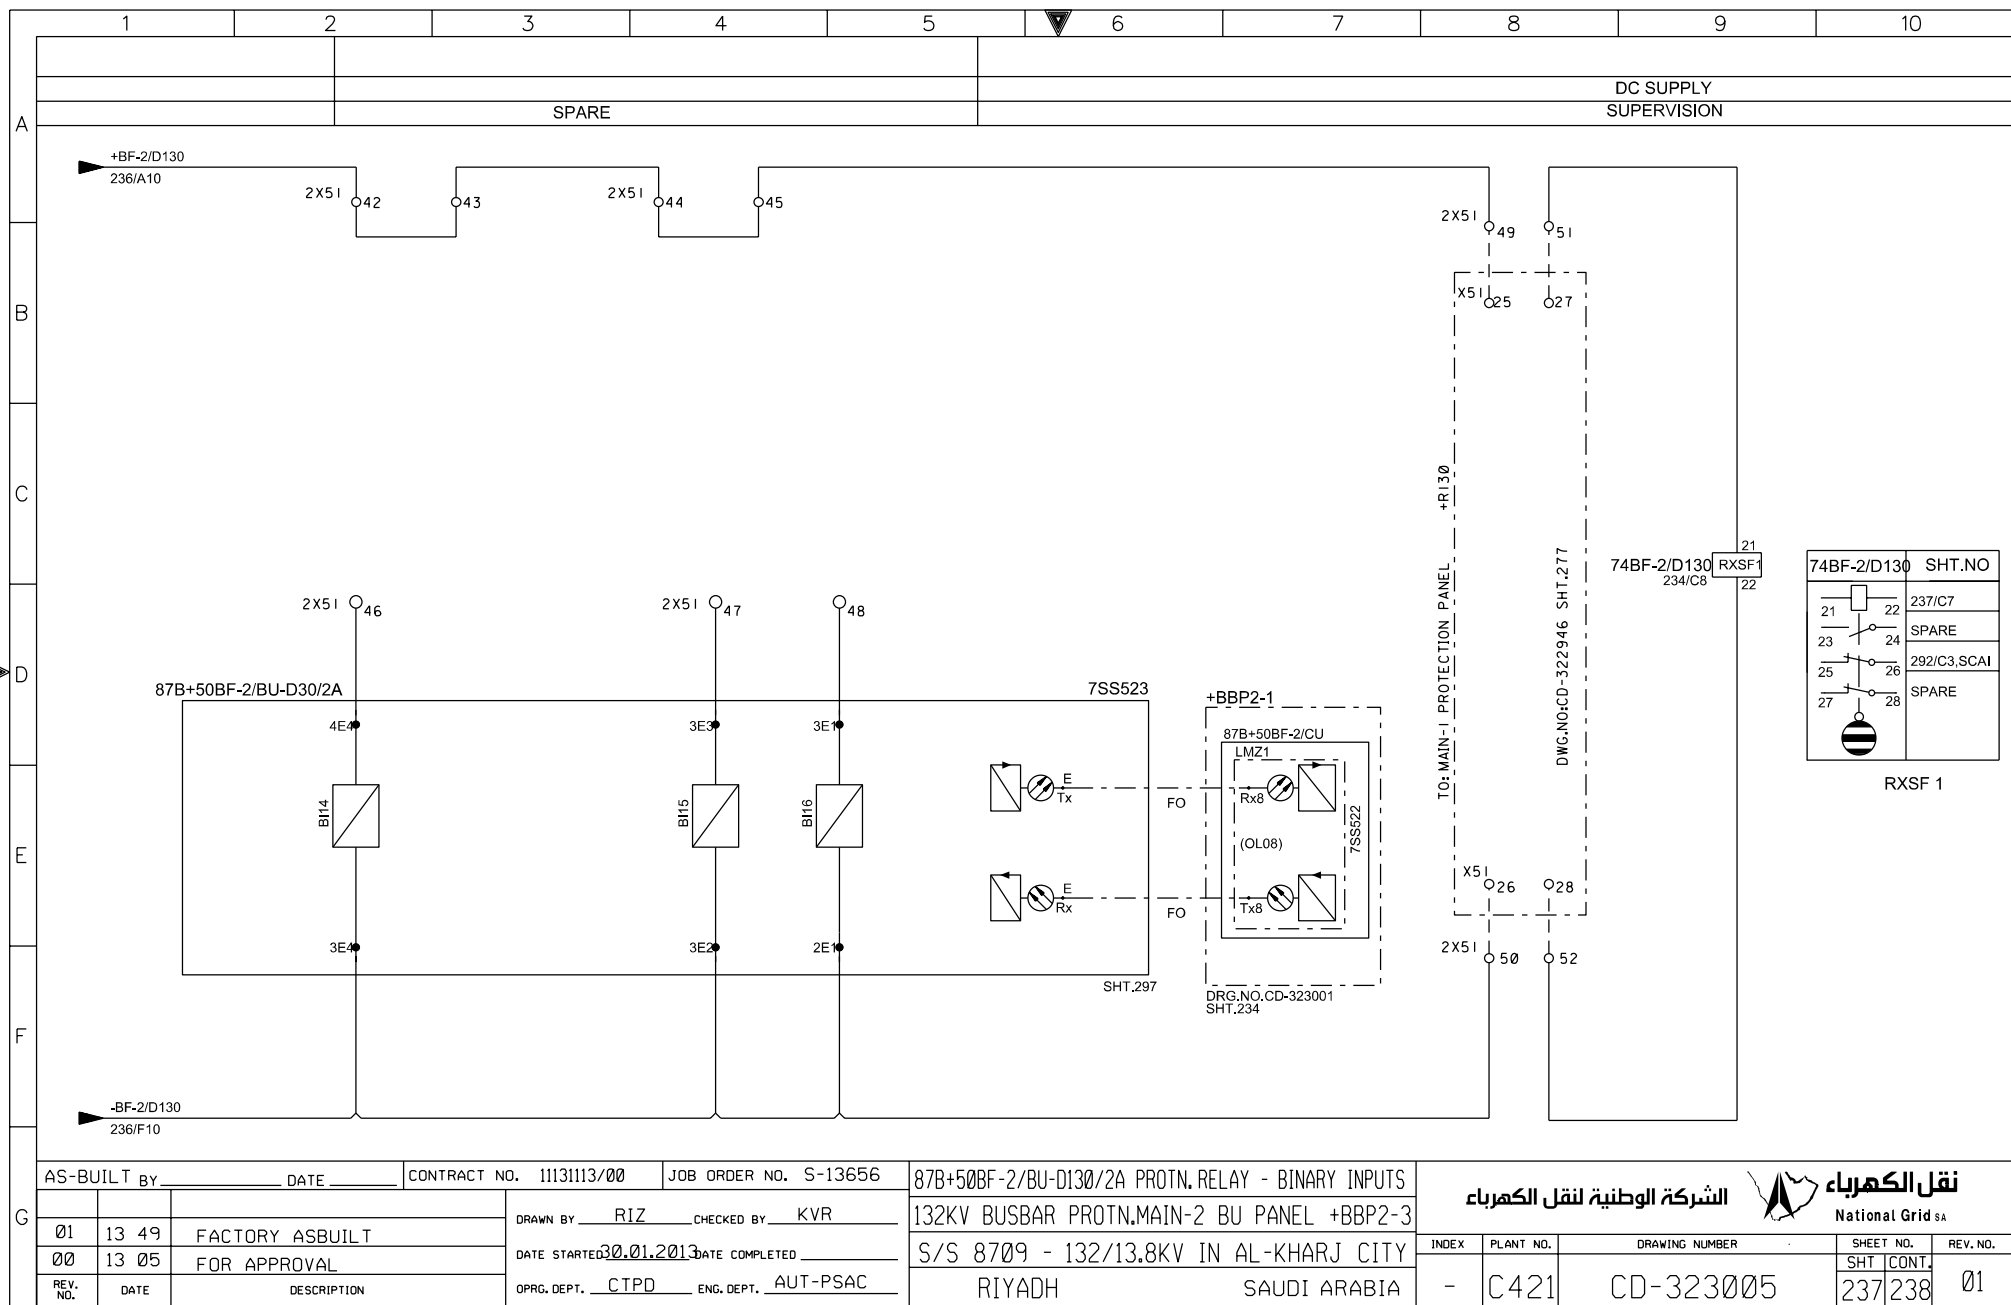


THIS DRAWING AND THE INFORMATION CONTAINED HEREIN ARE THE SOLE PROPERTY OF National Grid SA. NO REPRODUCTION IN FULL OR IN PART SHALL BE OBTAINED FROM THIS DOCUMENT WITHOUT THE WRITTEN CONSENT OF ITS OWNER.

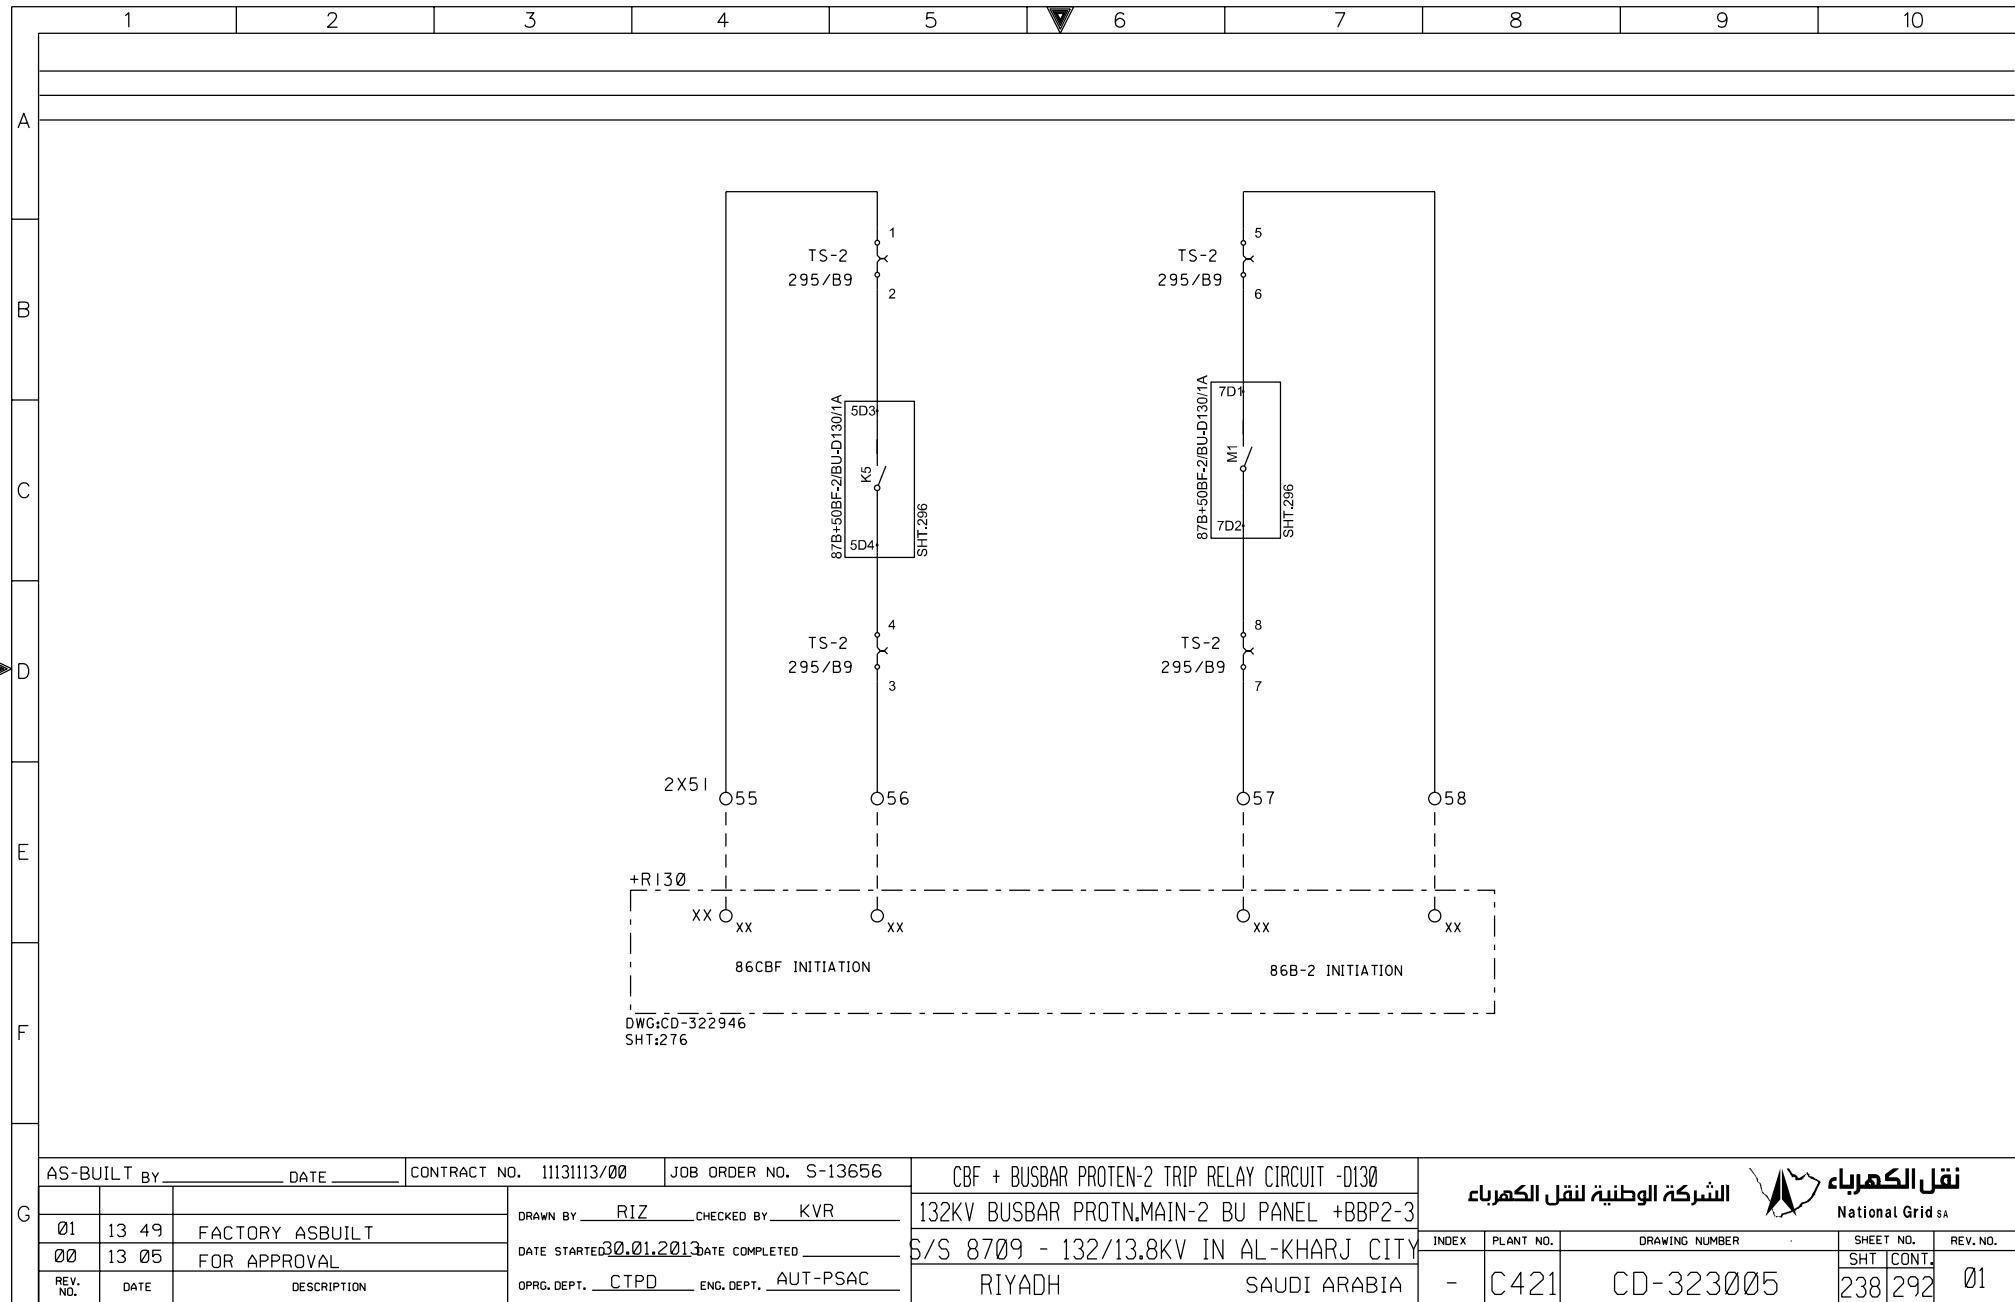


THIS DRAWING AND THE INFORMATION CONTAINED HEREIN ARE THE SOLE PROPERTY OF National Grid sa. NO REPRODUCTION IN FULL OR IN PART SHALL BE OBTAINED FROM THIS DOCUMENT WITHOUT THE WRITTEN CONSENT OF ITS OWNER.

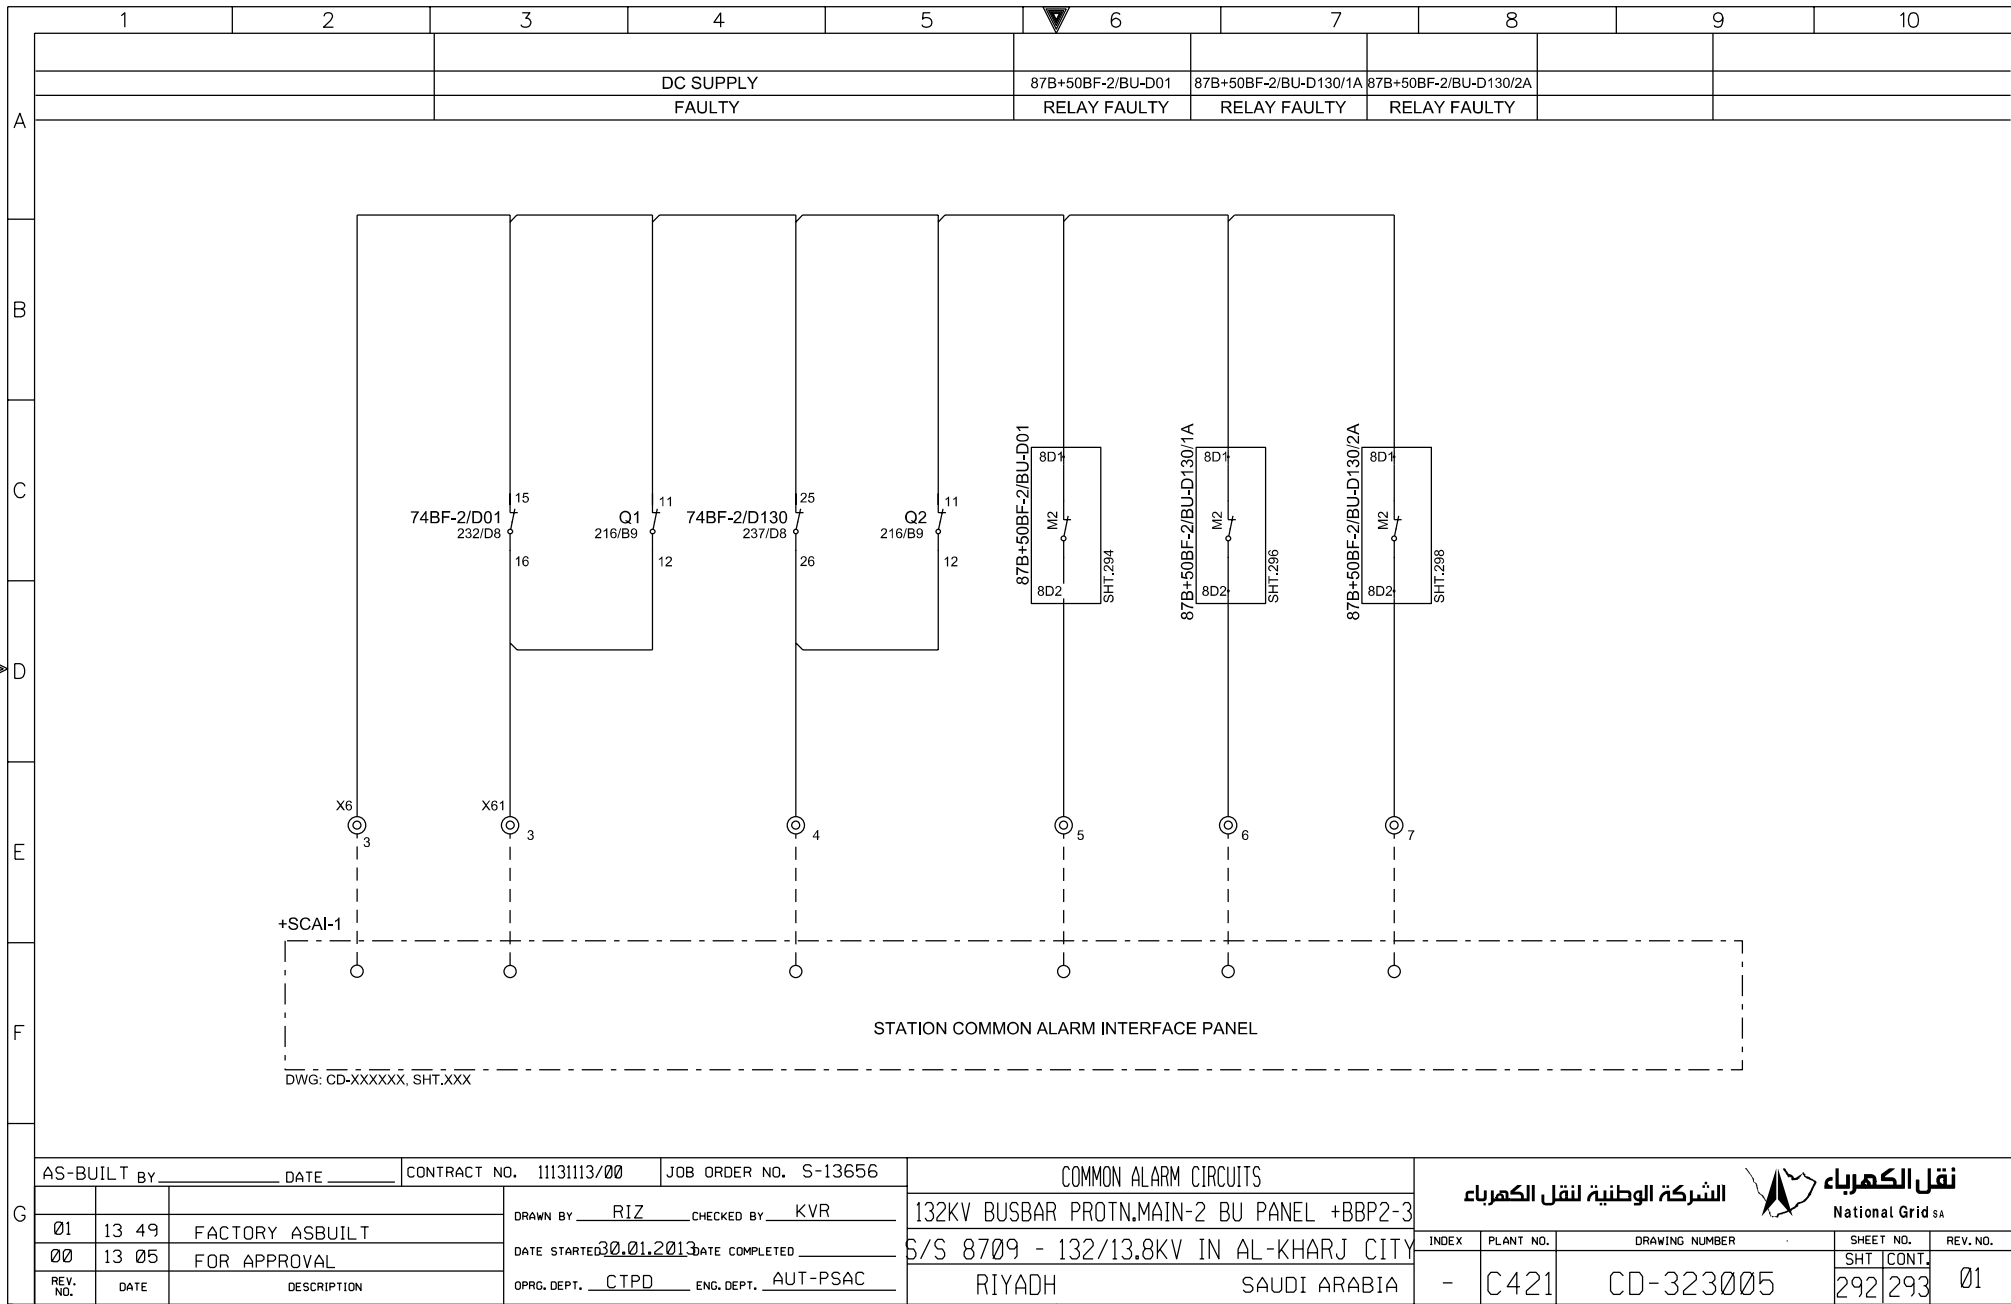

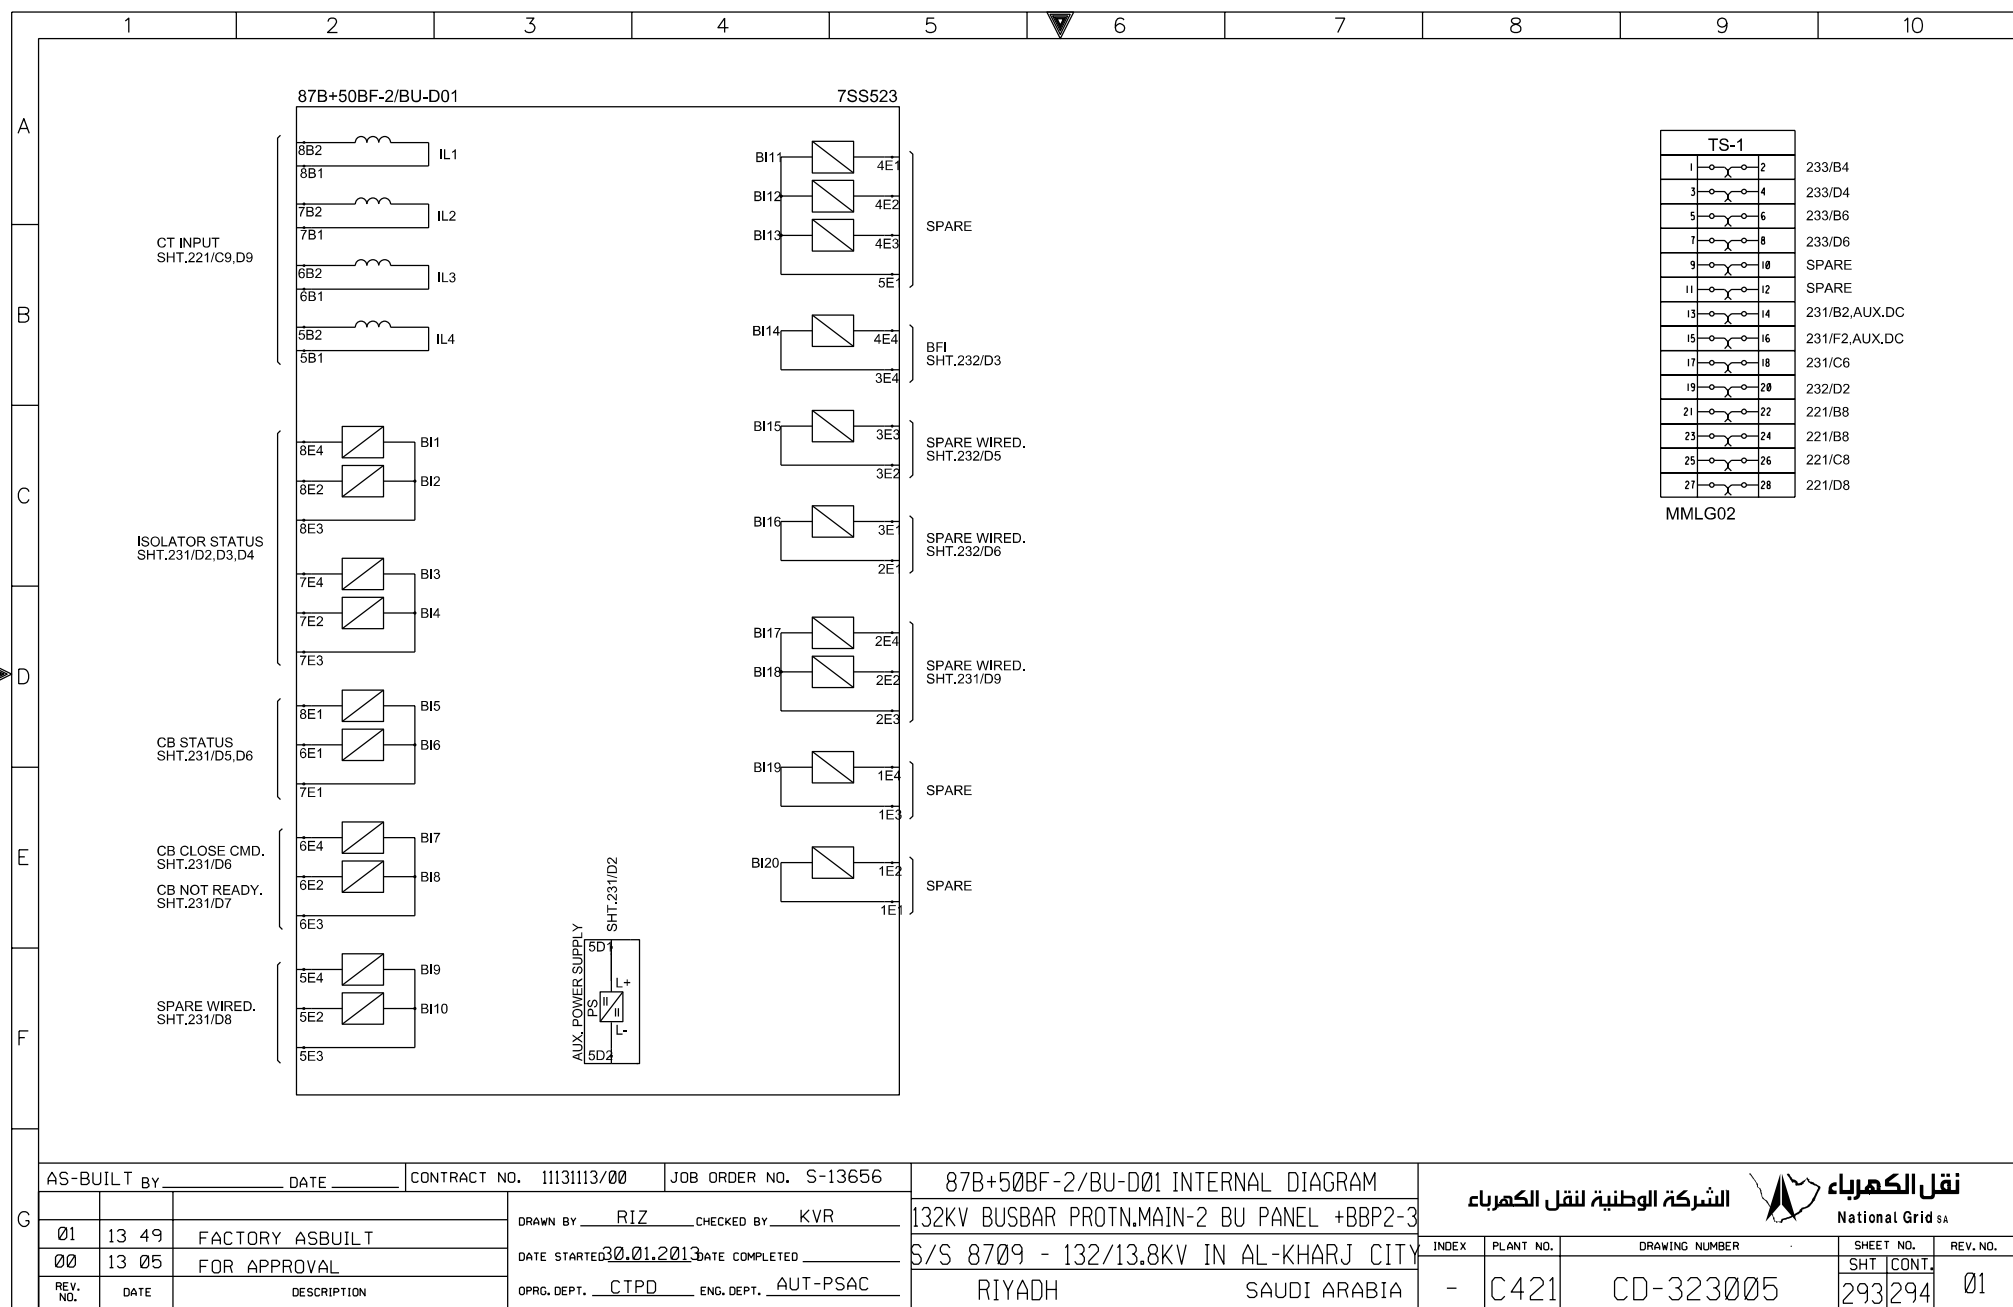
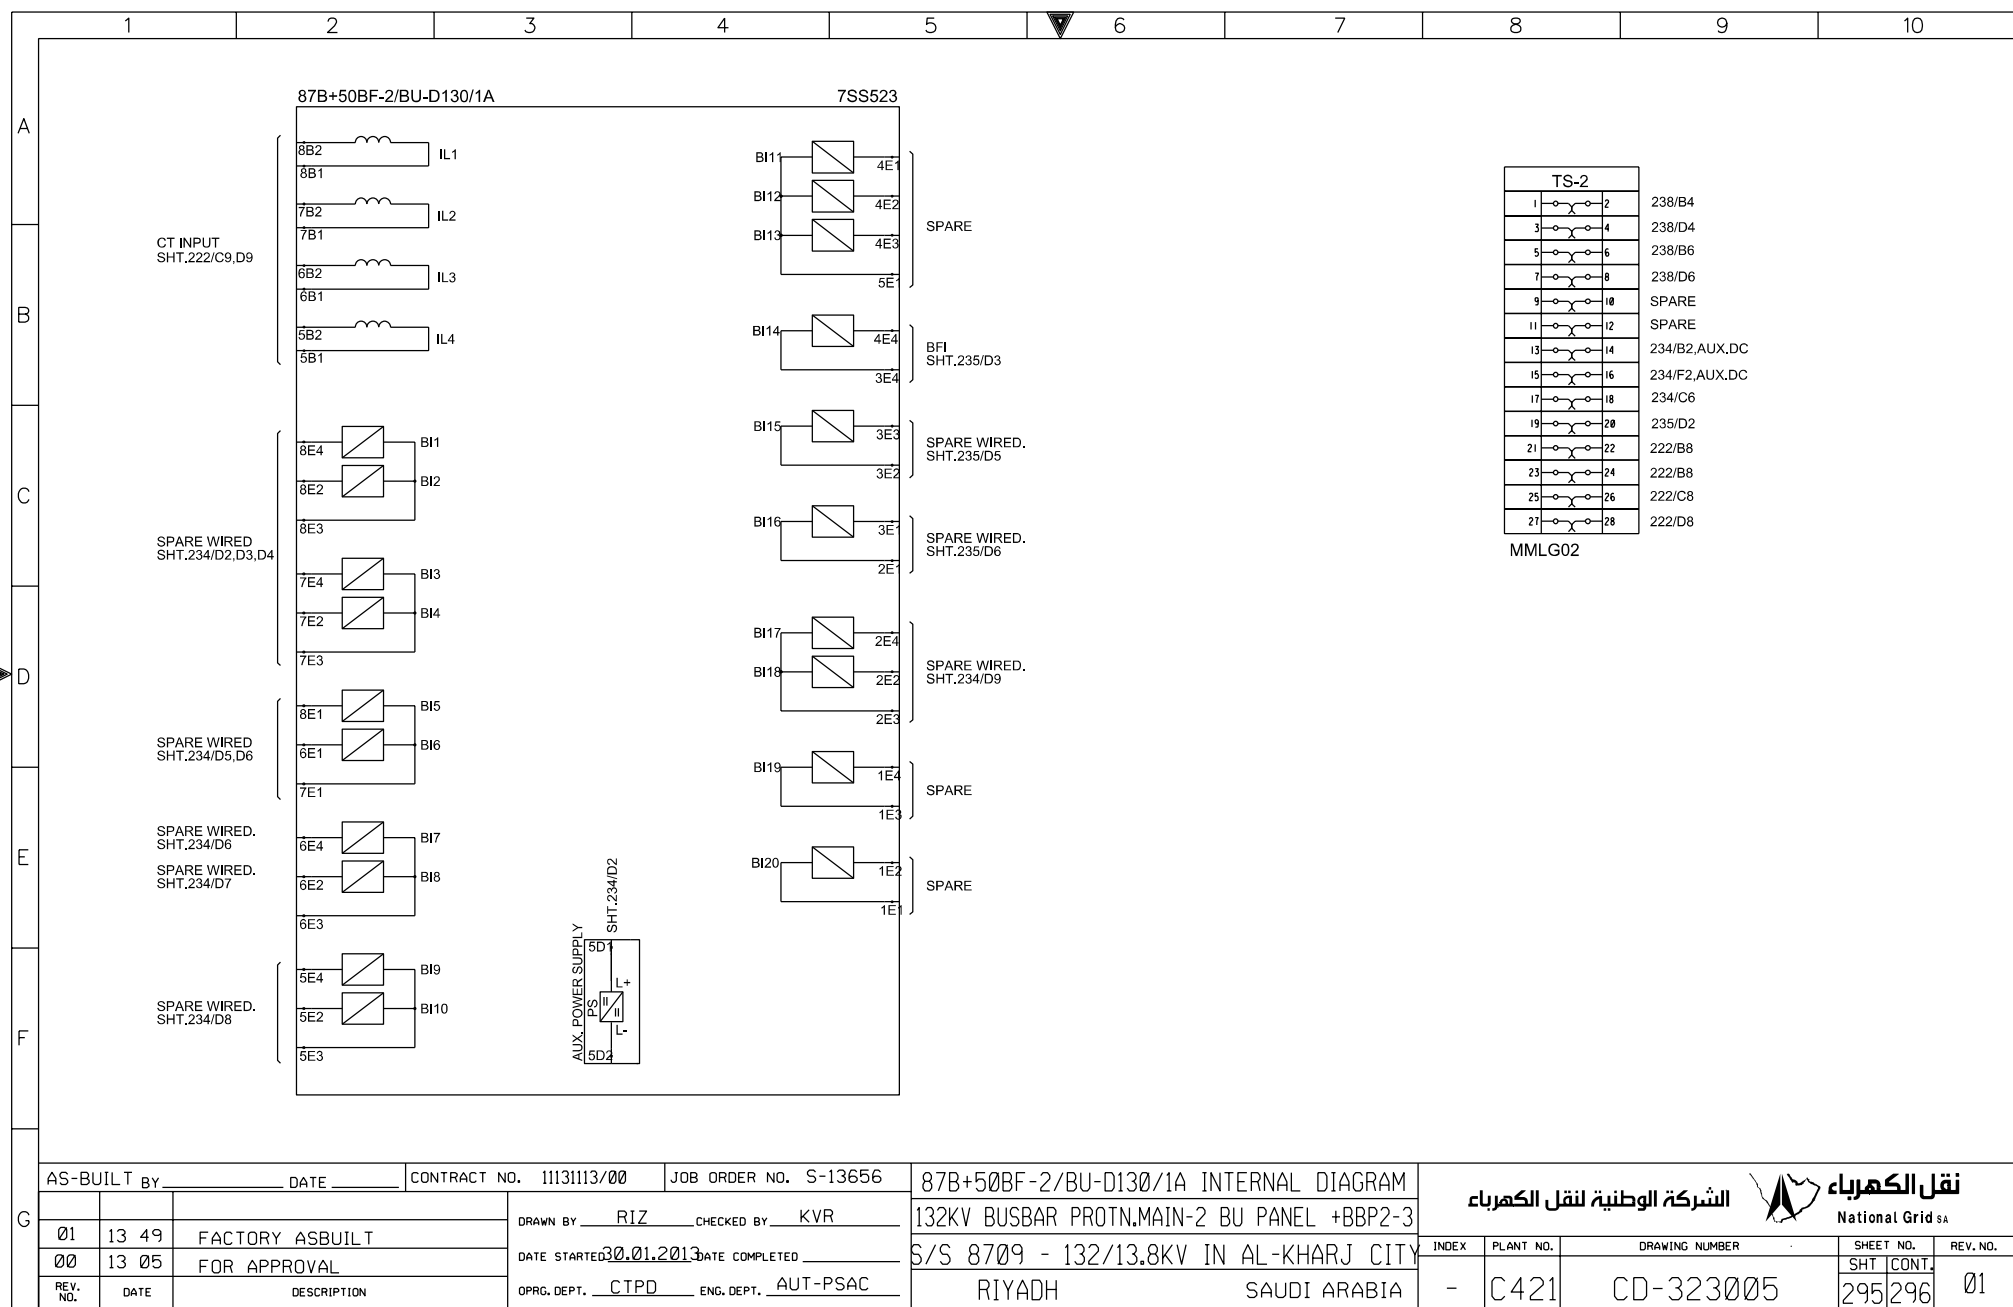


G	AS-BUILT BY _____ DATE _____		CONTRACT NO. 11131113/00	JOB ORDER NO. S-13656	87B+50BF-2/BU-D01 INTERNAL DIAGRAM		<div><div>الشركة الوطنية لنقل الكهرباء</div><div><div>نقل الكهرباء National Grid SA</div></div></div>							
	01	13 49	FACTORY ASBUILT		DRAWN BY RIZ	CHECKED BY KVR	132KV BUSBAR PROTN.MAIN-2 BU PANEL +BBP2-3		INDEX	PLANT NO.	DRAWING NUMBER	SHEET NO.		REV. NO.
	00	13 05	FOR APPROVAL		DATE STARTED 30.01.2013		DATE COMPLETED		S/S 8709 - 132/13.8KV IN AL-KHARJ CITY		SHT CONT.			
	REV. NO.	DATE	DESCRIPTION		OPRG. DEPT. CTPD	ENG. DEPT. AUT-PSAC	RIYADH SAUDI ARABIA		-	C421	CD-323005	293	294	01

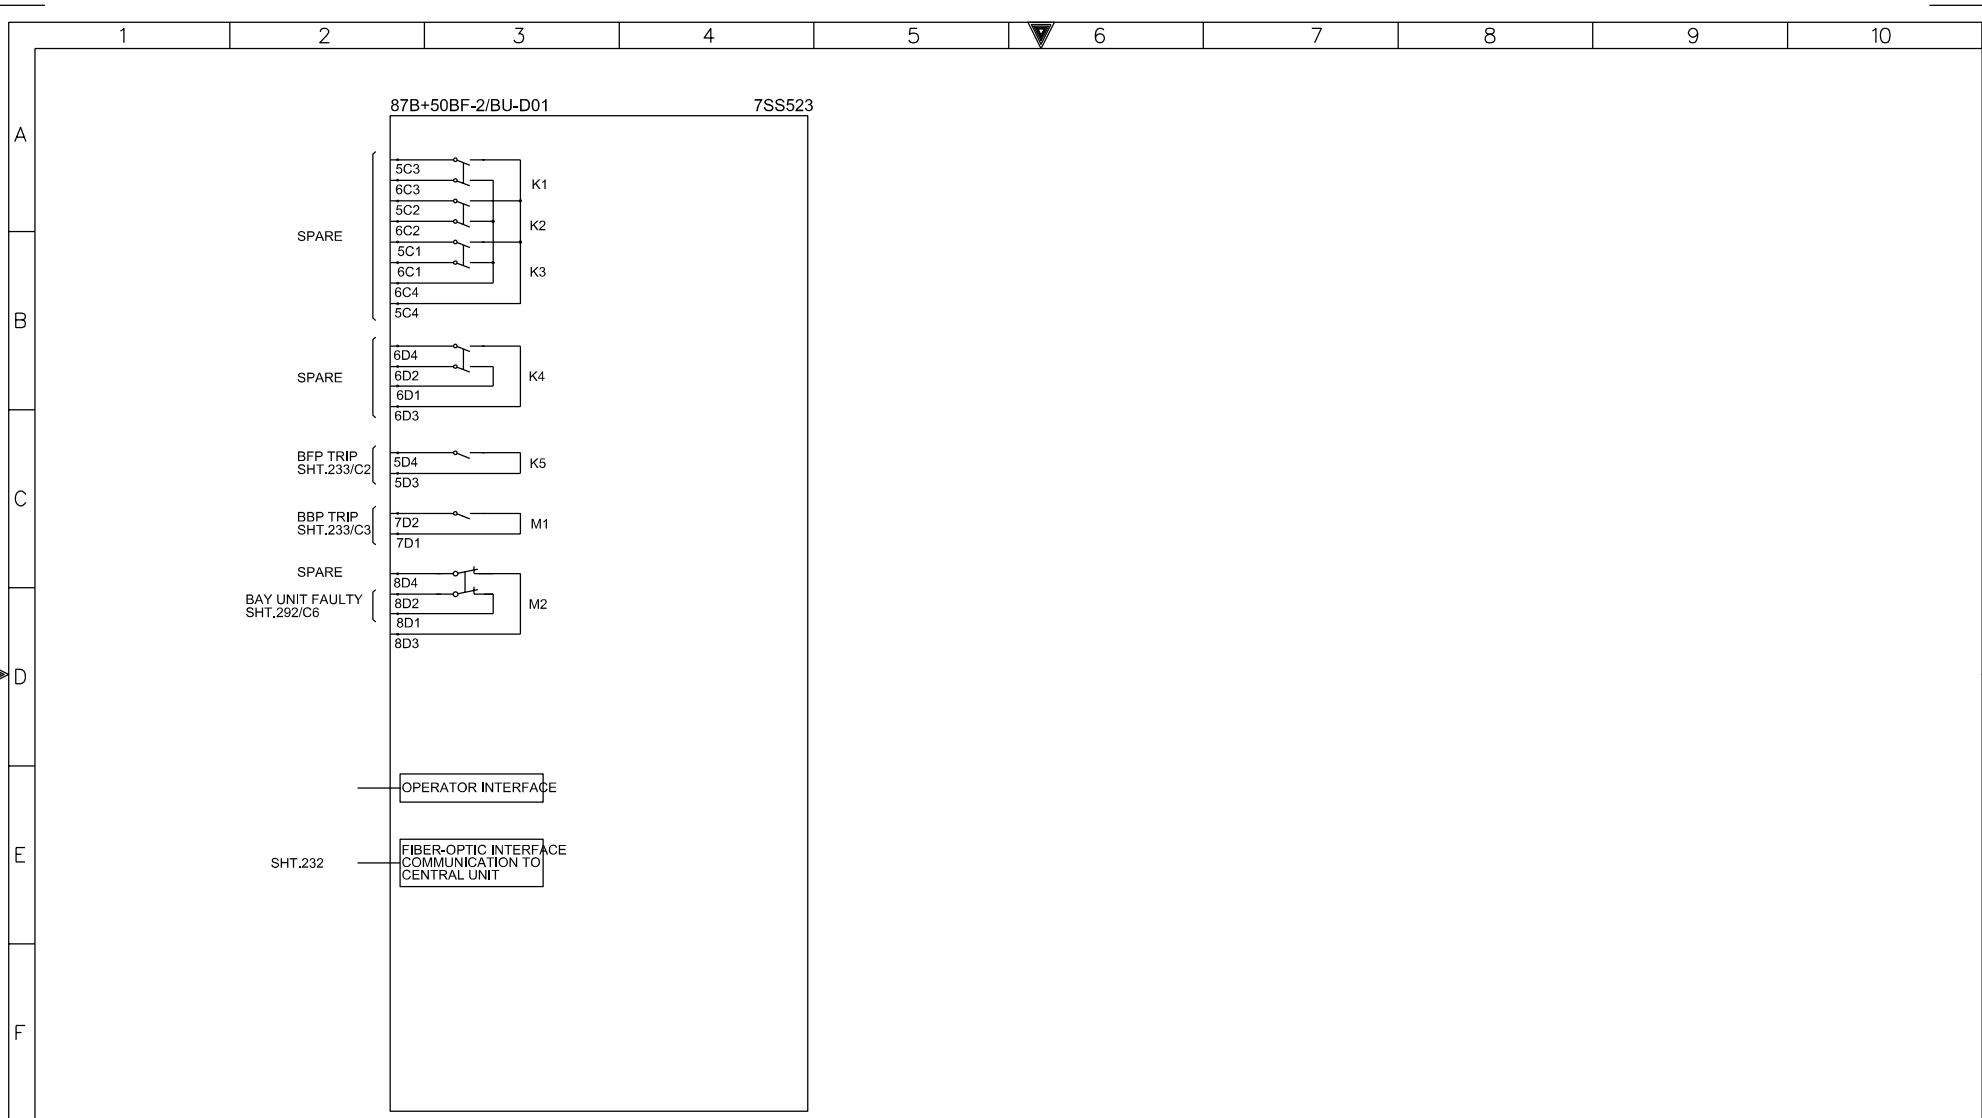


G


AS-BUILT BY _____ DATE _____			CONTRACT NO. 11131113/00		JOB ORDER NO. S-13656		87B+50BF-2/BU-D01 INTERNAL DIAGRAM				<div>الشركة الوطنية لنقل الكهرباء</div> <div> نقل الكهرباء</div> <div>National Grid SA</div>				
			DRAWN BY RIZ		CHECKED BY KVR		132KV BUSBAR PROTN.MAIN-2 BU PANEL +BBP2-3								
01 13 49 FACTORY ASBUILT			DATE STARTED 30.01.2013		DATE COMPLETED _____		S/S 8709 - 132/13.8KV IN AL-KHARJ CITY								
00 13 05 FOR APPROVAL															
REV. NO. DATE DESCRIPTION			OPRG. DEPT. CTPD		ENG. DEPT. AUT-PSAC		RIYADH SAUDI ARABIA				INDEX	PLANT NO.	DRAWING NUMBER	SHEET NO.	REV. NO.
											-	C421	CD-323005	SHT 294	CONT. 295
															01



THIS DRAWING AND THE INFORMATION CONTAINED HEREIN ARE THE SOLE PROPERTY OF NATIONAL GRID SA. NO REPRODUCTION IN FULL OR IN PART SHALL BE OBTAINED FROM THIS DOCUMENT WITHOUT THE WRITTEN CONSENT OF ITS OWNER.

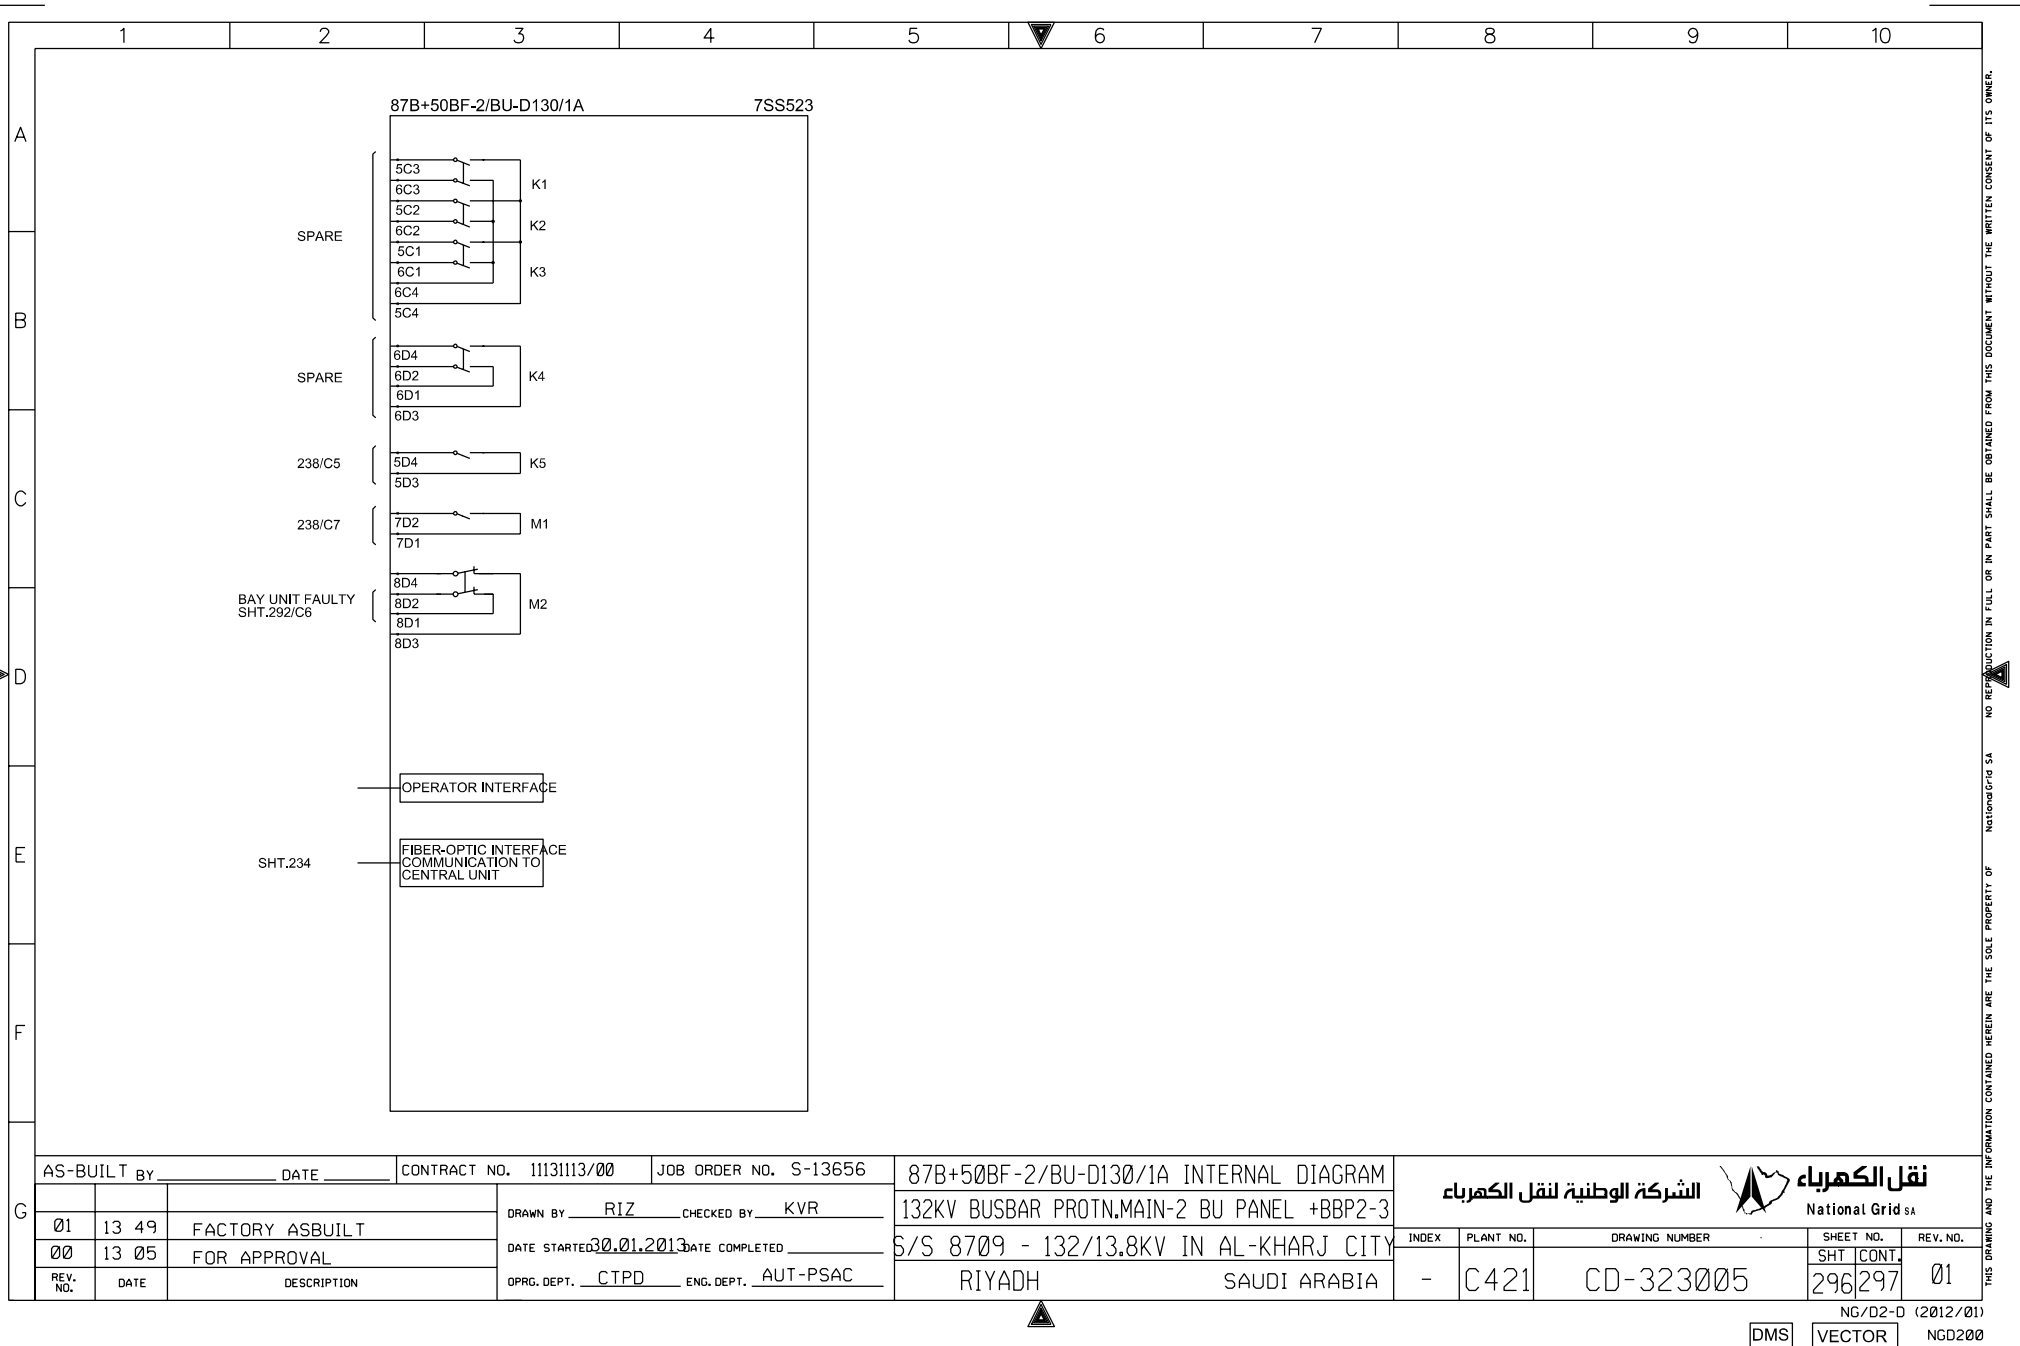


THIS DRAWING AND THE INFORMATION CONTAINED HEREIN ARE THE SOLE PROPERTY OF National Grid SA. NO REPRODUCTION IN FULL OR IN PART SHALL BE OBTAINED FROM THIS DOCUMENT WITHOUT THE WRITTEN CONSENT OF ITS OWNER.

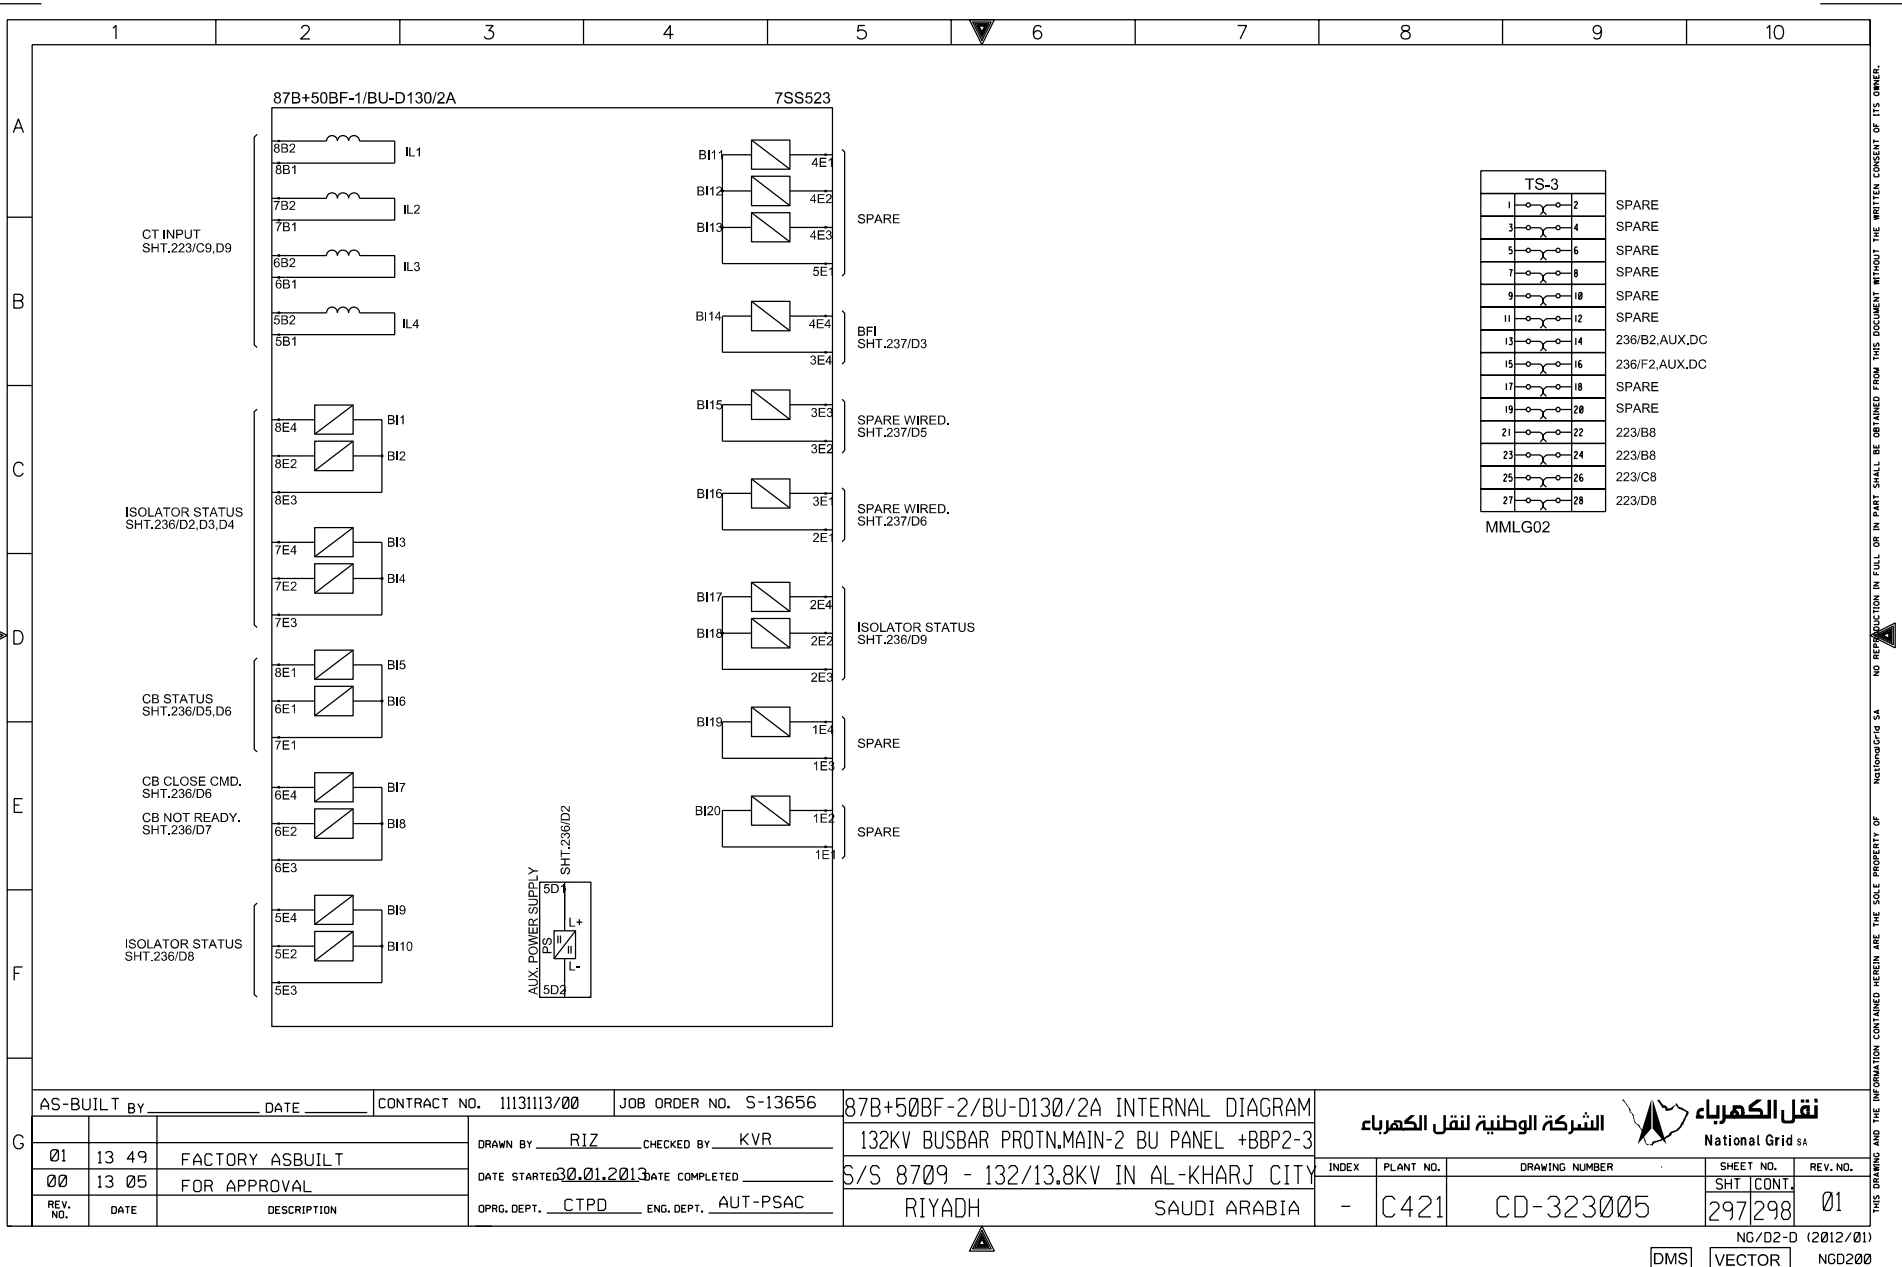

THIS DRAWING AND THE INFORMATION CONTAINED HEREIN ARE THE SOLE PROPERTY OF NATIONAL GRID SA. NO REPRODUCTION IN FULL OR IN PART SHALL BE OBTAINED FROM THIS DOCUMENT WITHOUT THE WRITTEN CONSENT OF ITS OWNER.

87B+50BF-1/BU-D130/2A 7SS523

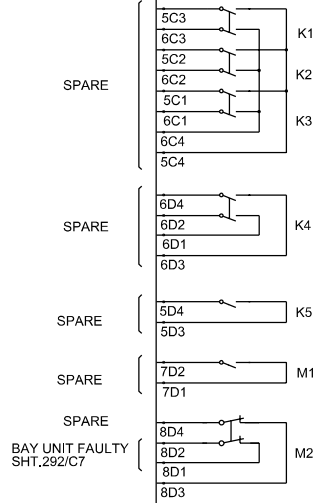

AS-BUILT BY _____ DATE _____ CONTRACT NO. 11131113/00 JOB ORDER NO. S-13656

01	13 49	FACTORY ASBUILT	DRAWN BY RIZ	CHECKED BY KVR
00	13 05	FOR APPROVAL	DATE STARTED 30.01.2013	DATE COMPLETED _____
REV. NO.	DATE	DESCRIPTION	OPRG. DEPT. CTPD	ENG. DEPT. AUT-PSAC

87B+50BF-2/BU-D130/2A INTERNAL DIAGRAM
132KV BUSBAR PROTN.MAIN-2 BU PANEL +BBP2-3
S/S 8709 - 132/13.8KV IN AL-KHARJ CITY
RIYADH SAUDI ARABIA

الشركة الوطنية لنقل الكهرباء		نقل الكهرباء		National Grid SA	
INDEX	PLANT NO.	DRAWING NUMBER	SHEET NO.	REV. NO.	
-	C421	CD-323005	SHT. CONT. 298/301	01	

NG/D2-D (2012/01)

DMS VECTOR NGD200

	1	2	3	4	5	6	7	8	9	10																																																																																																																																																																																																																																																																																																																																																																																																																																																							
A	<table border="1" style="width:100%; border-collapse: collapse;"> <tr><th>REFERENCE</th><th>1X1 CT CKT.</th></tr> <tr><td>221/B7</td><td>1</td></tr> <tr><td>221/B7</td><td>2</td></tr> <tr><td>221/C7</td><td>3</td></tr> <tr><td>221/C7</td><td>4</td></tr> <tr><td>221/C7</td><td>5</td></tr> <tr><td>221/C7</td><td>6</td></tr> <tr><td>221/C7</td><td>7</td></tr> <tr><td>221/D7</td><td>8</td></tr> <tr><td>221/D7</td><td>9</td></tr> <tr><td>SPARE</td><td>10</td></tr> </table>	REFERENCE	1X1 CT CKT.	221/B7	1	221/B7	2	221/C7	3	221/C7	4	221/C7	5	221/C7	6	221/C7	7	221/D7	8	221/D7	9	SPARE	10	<table border="1" style="width:100%; border-collapse: collapse;"> <tr><th>REFERENCE</th><th>2X1 CT CKT.</th></tr> <tr><td>222/B7</td><td>1</td></tr> <tr><td>222/B7</td><td>2</td></tr> <tr><td>222/C7</td><td>3</td></tr> <tr><td>222/C7</td><td>4</td></tr> <tr><td>222/C7</td><td>5</td></tr> <tr><td>222/C7</td><td>6</td></tr> <tr><td>222/C7</td><td>7</td></tr> <tr><td>222/D7</td><td>8</td></tr> <tr><td>222/D7</td><td>9</td></tr> <tr><td>SPARE</td><td>10</td></tr> <tr><td>223/B7</td><td>11</td></tr> <tr><td>223/C7</td><td>12</td></tr> <tr><td>223/C7</td><td>13</td></tr> <tr><td>223/C7</td><td>14</td></tr> <tr><td>223/C7</td><td>15</td></tr> <tr><td>223/C7</td><td>16</td></tr> <tr><td>223/C7</td><td>17</td></tr> <tr><td>223/D7</td><td>18</td></tr> <tr><td>223/D7</td><td>19</td></tr> <tr><td>SPARE</td><td>20</td></tr> <tr><td>SPARE</td><td>21</td></tr> <tr><td>SPARE</td><td>22</td></tr> <tr><td>SPARE</td><td>23</td></tr> <tr><td>SPARE</td><td>24</td></tr> <tr><td>SPARE</td><td>25</td></tr> </table>	REFERENCE	2X1 CT CKT.	222/B7	1	222/B7	2	222/C7	3	222/C7	4	222/C7	5	222/C7	6	222/C7	7	222/D7	8	222/D7	9	SPARE	10	223/B7	11	223/C7	12	223/C7	13	223/C7	14	223/C7	15	223/C7	16	223/C7	17	223/D7	18	223/D7	19	SPARE	20	SPARE	21	SPARE	22	SPARE	23	SPARE	24	SPARE	25	<table border="1" style="width:100%; border-collapse: collapse;"> <tr><th>REFERENCE</th><th>1X51 CON & PROTIN CKTS.</th></tr> <tr><td>231/A3</td><td>1</td></tr> <tr><td>231/C2</td><td>2</td></tr> <tr><td>231/C3</td><td>3</td></tr> <tr><td>231/C4</td><td>4</td></tr> <tr><td>231/C3</td><td>5</td></tr> <tr><td>231/C4</td><td>6</td></tr> <tr><td>231/C4</td><td>7</td></tr> <tr><td>231/C4</td><td>8</td></tr> <tr><td>231/A7</td><td>9</td></tr> <tr><td>231/C5</td><td>10</td></tr> <tr><td>231/A8</td><td>11</td></tr> <tr><td>231/C6</td><td>12</td></tr> <tr><td>231/C7</td><td>13</td></tr> <tr><td>231/C7</td><td>14</td></tr> <tr><td>231/A9</td><td>15</td></tr> <tr><td>231/C10</td><td>16</td></tr> <tr><td>232/A2</td><td>17</td></tr> <tr><td>232/A2</td><td>18</td></tr> <tr><td>232/A3</td><td>19</td></tr> <tr><td>232/A4</td><td>20</td></tr> <tr><td>232/C2</td><td>21</td></tr> <tr><td>232/C4</td><td>22</td></tr> <tr><td>SPARE</td><td>23</td></tr> <tr><td>232/C4</td><td>24</td></tr> <tr><td>232/C4</td><td>25</td></tr> <tr><td>232/C4</td><td>26</td></tr> <tr><td>232/B7</td><td>27</td></tr> <tr><td>232/E7</td><td>28</td></tr> <tr><td>232/B8</td><td>29</td></tr> <tr><td>232/E8</td><td>30</td></tr> <tr><td>233/E4</td><td>31</td></tr> <tr><td>233/E5</td><td>32</td></tr> <tr><td>233/E6</td><td>33</td></tr> <tr><td>233/E7</td><td>34</td></tr> <tr><td>SPARE</td><td>35</td></tr> <tr><td>SPARE</td><td>36</td></tr> <tr><td>SPARE</td><td>37</td></tr> <tr><td>SPARE</td><td>38</td></tr> <tr><td>SPARE</td><td>39</td></tr> <tr><td>SPARE</td><td>40</td></tr> <tr><td>SPARE</td><td>41</td></tr> <tr><td>SPARE</td><td>42</td></tr> <tr><td>SPARE</td><td>43</td></tr> <tr><td>SPARE</td><td>44</td></tr> <tr><td>SPARE</td><td>45</td></tr> <tr><td>SPARE</td><td>46</td></tr> <tr><td>SPARE</td><td>47</td></tr> <tr><td>SPARE</td><td>48</td></tr> <tr><td>SPARE</td><td>49</td></tr> <tr><td>SPARE</td><td>50</td></tr> </table>	REFERENCE	1X51 CON & PROTIN CKTS.	231/A3	1	231/C2	2	231/C3	3	231/C4	4	231/C3	5	231/C4	6	231/C4	7	231/C4	8	231/A7	9	231/C5	10	231/A8	11	231/C6	12	231/C7	13	231/C7	14	231/A9	15	231/C10	16	232/A2	17	232/A2	18	232/A3	19	232/A4	20	232/C2	21	232/C4	22	SPARE	23	232/C4	24	232/C4	25	232/C4	26	232/B7	27	232/E7	28	232/B8	29	232/E8	30	233/E4	31	233/E5	32	233/E6	33	233/E7	34	SPARE	35	SPARE	36	SPARE	37	SPARE	38	SPARE	39	SPARE	40	SPARE	41	SPARE	42	SPARE	43	SPARE	44	SPARE	45	SPARE	46	SPARE	47	SPARE	48	SPARE	49	SPARE	50	<table border="1" style="width:100%; border-collapse: collapse;"> <tr><th>REFERENCE</th><th>X3 AC CKT.</th></tr> <tr><td>211/A3</td><td>1</td></tr> <tr><td>211/A7</td><td>2</td></tr> <tr><td>211/A3</td><td>3</td></tr> <tr><td>211/A7</td><td>4</td></tr> <tr><td>211/B3</td><td>5</td></tr> <tr><td>211/B7</td><td>6</td></tr> <tr><td>211/B3</td><td>7</td></tr> <tr><td>211/B7</td><td>8</td></tr> <tr><td>SPARE</td><td>9</td></tr> <tr><td>SPARE</td><td>10</td></tr> </table>	REFERENCE	X3 AC CKT.	211/A3	1	211/A7	2	211/A3	3	211/A7	4	211/B3	5	211/B7	6	211/B3	7	211/B7	8	SPARE	9	SPARE	10	<table border="1" style="width:100%; border-collapse: collapse;"> <tr><th>REFERENCE</th><th>2X51 CON & PROTIN CKTS.</th></tr> <tr><td>237/A3</td><td>1</td></tr> <tr><td>237/C2</td><td>2</td></tr> <tr><td>237/C3</td><td>3</td></tr> <tr><td>237/C4</td><td>4</td></tr> <tr><td>237/C3</td><td>5</td></tr> <tr><td>237/C4</td><td>6</td></tr> <tr><td>237/C4</td><td>7</td></tr> <tr><td>237/C4</td><td>8</td></tr> <tr><td>237/A7</td><td>9</td></tr> <tr><td>237/C5</td><td>10</td></tr> <tr><td>237/A8</td><td>11</td></tr> <tr><td>237/C6</td><td>12</td></tr> <tr><td>237/C7</td><td>13</td></tr> <tr><td>237/C7</td><td>14</td></tr> <tr><td>237/A9</td><td>15</td></tr> <tr><td>237/C10</td><td>16</td></tr> <tr><td>235/A2</td><td>17</td></tr> <tr><td>235/A2</td><td>18</td></tr> <tr><td>235/A3</td><td>19</td></tr> <tr><td>235/A4</td><td>20</td></tr> <tr><td>235/C2</td><td>21</td></tr> <tr><td>235/C4</td><td>22</td></tr> <tr><td>235/C4</td><td>23</td></tr> <tr><td>SPARE</td><td>24</td></tr> <tr><td>SPARE</td><td>25</td></tr> <tr><td>236/A3</td><td>26</td></tr> <tr><td>236/A6</td><td>27</td></tr> <tr><td>236/A8</td><td>28</td></tr> <tr><td>236/A9</td><td>29</td></tr> <tr><td>236/C3</td><td>30</td></tr> <tr><td>236/C3</td><td>31</td></tr> <tr><td>236/C4</td><td>32</td></tr> <tr><td>236/C4</td><td>33</td></tr> <tr><td>236/C5</td><td>34</td></tr> <tr><td>236/C5</td><td>35</td></tr> <tr><td>236/C6</td><td>36</td></tr> <tr><td>236/C6</td><td>37</td></tr> <tr><td>236/C7</td><td>38</td></tr> <tr><td>236/C8</td><td>39</td></tr> <tr><td>236/C9</td><td>40</td></tr> <tr><td>236/C9</td><td>41</td></tr> <tr><td>237/A2</td><td>42</td></tr> <tr><td>237/A2</td><td>43</td></tr> <tr><td>237/A3</td><td>44</td></tr> <tr><td>237/A4</td><td>45</td></tr> <tr><td>237/D2</td><td>46</td></tr> <tr><td>237/D4</td><td>47</td></tr> <tr><td>237/D5</td><td>48</td></tr> <tr><td>237/A8</td><td>49</td></tr> <tr><td>237/F8</td><td>50</td></tr> </table>	REFERENCE	2X51 CON & PROTIN CKTS.	237/A3	1	237/C2	2	237/C3	3	237/C4	4	237/C3	5	237/C4	6	237/C4	7	237/C4	8	237/A7	9	237/C5	10	237/A8	11	237/C6	12	237/C7	13	237/C7	14	237/A9	15	237/C10	16	235/A2	17	235/A2	18	235/A3	19	235/A4	20	235/C2	21	235/C4	22	235/C4	23	SPARE	24	SPARE	25	236/A3	26	236/A6	27	236/A8	28	236/A9	29	236/C3	30	236/C3	31	236/C4	32	236/C4	33	236/C5	34	236/C5	35	236/C6	36	236/C6	37	236/C7	38	236/C8	39	236/C9	40	236/C9	41	237/A2	42	237/A2	43	237/A3	44	237/A4	45	237/D2	46	237/D4	47	237/D5	48	237/A8	49	237/F8	50	<table border="1" style="width:100%; border-collapse: collapse;"> <tr><th>REFERENCE</th><th>2X51 CON & PROTIN CKTS.</th></tr> <tr><td>237/B8</td><td>51</td></tr> <tr><td>237/F8</td><td>52</td></tr> <tr><td>SPARE</td><td>53</td></tr> <tr><td>SPARE</td><td>54</td></tr> <tr><td>238/E4</td><td>55</td></tr> <tr><td>238/E5</td><td>56</td></tr> <tr><td>238/E6</td><td>57</td></tr> <tr><td>238/E7</td><td>58</td></tr> <tr><td>SPARE</td><td>59</td></tr> <tr><td>SPARE</td><td>60</td></tr> <tr><td>SPARE</td><td>61</td></tr> <tr><td>SPARE</td><td>62</td></tr> <tr><td>SPARE</td><td>63</td></tr> <tr><td>SPARE</td><td>64</td></tr> <tr><td>SPARE</td><td>65</td></tr> <tr><td>SPARE</td><td>66</td></tr> <tr><td>SPARE</td><td>67</td></tr> <tr><td>SPARE</td><td>68</td></tr> <tr><td>SPARE</td><td>69</td></tr> <tr><td>SPARE</td><td>70</td></tr> <tr><td>SPARE</td><td>71</td></tr> <tr><td>SPARE</td><td>72</td></tr> <tr><td>SPARE</td><td>73</td></tr> <tr><td>SPARE</td><td>74</td></tr> <tr><td>SPARE</td><td>75</td></tr> </table>	REFERENCE	2X51 CON & PROTIN CKTS.	237/B8	51	237/F8	52	SPARE	53	SPARE	54	238/E4	55	238/E5	56	238/E6	57	238/E7	58	SPARE	59	SPARE	60	SPARE	61	SPARE	62	SPARE	63	SPARE	64	SPARE	65	SPARE	66	SPARE	67	SPARE	68	SPARE	69	SPARE	70	SPARE	71	SPARE	72	SPARE	73	SPARE	74	SPARE	75	<table border="1" style="width:100%; border-collapse: collapse;"> <tr><th>REFERENCE</th><th>X4 DC CKTS.</th></tr> <tr><td>216/B3</td><td>1</td></tr> <tr><td>216/B3</td><td>2</td></tr> <tr><td>216/D3</td><td>3</td></tr> <tr><td>216/D3</td><td>4</td></tr> <tr><td>SPARE</td><td>5</td></tr> <tr><td>SPARE</td><td>6</td></tr> <tr><td>SPARE</td><td>7</td></tr> <tr><td>SPARE</td><td>8</td></tr> <tr><td>SPARE</td><td>9</td></tr> <tr><td>SPARE</td><td>10</td></tr> </table>	REFERENCE	X4 DC CKTS.	216/B3	1	216/B3	2	216/D3	3	216/D3	4	SPARE	5	SPARE	6	SPARE	7	SPARE	8	SPARE	9	SPARE	10	<table border="1" style="width:100%; border-collapse: collapse;"> <tr><th>REFERENCE</th><th>X61 ALM. CKT.</th></tr> <tr><td>212/E5</td><td>1</td></tr> <tr><td>212/E5</td><td>2</td></tr> <tr><td>292/E4</td><td>3</td></tr> <tr><td>292/E5</td><td>4</td></tr> <tr><td>292/E6</td><td>5</td></tr> <tr><td>292/E7</td><td>6</td></tr> <tr><td>292/E7</td><td>7</td></tr> <tr><td>SPARE</td><td>8</td></tr> <tr><td>SPARE</td><td>9</td></tr> <tr><td>SPARE</td><td>10</td></tr> <tr><td>SPARE</td><td>11</td></tr> <tr><td>SPARE</td><td>12</td></tr> <tr><td>SPARE</td><td>13</td></tr> <tr><td>SPARE</td><td>14</td></tr> <tr><td>SPARE</td><td>15</td></tr> </table>	REFERENCE	X61 ALM. CKT.	212/E5	1	212/E5	2	292/E4	3	292/E5	4	292/E6	5	292/E7	6	292/E7	7	SPARE	8	SPARE	9	SPARE	10	SPARE	11	SPARE	12	SPARE	13	SPARE	14	SPARE	15	<table border="1" style="width:100%; border-collapse: collapse;"> <tr><th>REFERENCE</th><th>X6 ALM. CKT.</th></tr> <tr><td>212/C5</td><td>1</td></tr> <tr><td>212/C5</td><td>2</td></tr> <tr><td>292/E3</td><td>3</td></tr> <tr><td>SPARE</td><td>4</td></tr> <tr><td>SPARE</td><td>5</td></tr> </table>	REFERENCE	X6 ALM. CKT.	212/C5	1	212/C5	2	292/E3	3	SPARE	4	SPARE	5	<table border="1" style="width:100%; border-collapse: collapse;"> <tr><th>REFERENCE</th><th>XTJ T.JACK</th></tr> <tr><td>211/C3</td><td>1</td></tr> <tr><td>211/D3</td><td>2</td></tr> <tr><td>211/D3</td><td>3</td></tr> <tr><td>211/D3</td><td>4</td></tr> <tr><td>SPARE</td><td>5</td></tr> </table>	REFERENCE	XTJ T.JACK	211/C3	1	211/D3	2	211/D3	3	211/D3	4	SPARE	5	<table border="1" style="width:100%; border-collapse: collapse;"> <tr><th>REFERENCE</th><th>XSH SPACE HEATER</th></tr> <tr><td>211/E6</td><td>1</td></tr> <tr><td>211/F6</td><td>2</td></tr> <tr><td>SPARE</td><td>3</td></tr> </table>	REFERENCE	XSH SPACE HEATER	211/E6	1	211/F6	2	SPARE	3
REFERENCE	1X1 CT CKT.																																																																																																																																																																																																																																																																																																																																																																																																																																																																
221/B7	1																																																																																																																																																																																																																																																																																																																																																																																																																																																																
221/B7	2																																																																																																																																																																																																																																																																																																																																																																																																																																																																
221/C7	3																																																																																																																																																																																																																																																																																																																																																																																																																																																																
221/C7	4																																																																																																																																																																																																																																																																																																																																																																																																																																																																
221/C7	5																																																																																																																																																																																																																																																																																																																																																																																																																																																																
221/C7	6																																																																																																																																																																																																																																																																																																																																																																																																																																																																
221/C7	7																																																																																																																																																																																																																																																																																																																																																																																																																																																																
221/D7	8																																																																																																																																																																																																																																																																																																																																																																																																																																																																
221/D7	9																																																																																																																																																																																																																																																																																																																																																																																																																																																																
SPARE	10																																																																																																																																																																																																																																																																																																																																																																																																																																																																
REFERENCE	2X1 CT CKT.																																																																																																																																																																																																																																																																																																																																																																																																																																																																
222/B7	1																																																																																																																																																																																																																																																																																																																																																																																																																																																																
222/B7	2																																																																																																																																																																																																																																																																																																																																																																																																																																																																
222/C7	3																																																																																																																																																																																																																																																																																																																																																																																																																																																																
222/C7	4																																																																																																																																																																																																																																																																																																																																																																																																																																																																
222/C7	5																																																																																																																																																																																																																																																																																																																																																																																																																																																																
222/C7	6																																																																																																																																																																																																																																																																																																																																																																																																																																																																
222/C7	7																																																																																																																																																																																																																																																																																																																																																																																																																																																																
222/D7	8																																																																																																																																																																																																																																																																																																																																																																																																																																																																
222/D7	9																																																																																																																																																																																																																																																																																																																																																																																																																																																																
SPARE	10																																																																																																																																																																																																																																																																																																																																																																																																																																																																
223/B7	11																																																																																																																																																																																																																																																																																																																																																																																																																																																																
223/C7	12																																																																																																																																																																																																																																																																																																																																																																																																																																																																
223/C7	13																																																																																																																																																																																																																																																																																																																																																																																																																																																																
223/C7	14																																																																																																																																																																																																																																																																																																																																																																																																																																																																
223/C7	15																																																																																																																																																																																																																																																																																																																																																																																																																																																																
223/C7	16																																																																																																																																																																																																																																																																																																																																																																																																																																																																
223/C7	17																																																																																																																																																																																																																																																																																																																																																																																																																																																																
223/D7	18																																																																																																																																																																																																																																																																																																																																																																																																																																																																
223/D7	19																																																																																																																																																																																																																																																																																																																																																																																																																																																																
SPARE	20																																																																																																																																																																																																																																																																																																																																																																																																																																																																
SPARE	21																																																																																																																																																																																																																																																																																																																																																																																																																																																																
SPARE	22																																																																																																																																																																																																																																																																																																																																																																																																																																																																
SPARE	23																																																																																																																																																																																																																																																																																																																																																																																																																																																																
SPARE	24																																																																																																																																																																																																																																																																																																																																																																																																																																																																
SPARE	25																																																																																																																																																																																																																																																																																																																																																																																																																																																																
REFERENCE	1X51 CON & PROTIN CKTS.																																																																																																																																																																																																																																																																																																																																																																																																																																																																
231/A3	1																																																																																																																																																																																																																																																																																																																																																																																																																																																																
231/C2	2																																																																																																																																																																																																																																																																																																																																																																																																																																																																
231/C3	3																																																																																																																																																																																																																																																																																																																																																																																																																																																																
231/C4	4																																																																																																																																																																																																																																																																																																																																																																																																																																																																
231/C3	5																																																																																																																																																																																																																																																																																																																																																																																																																																																																
231/C4	6																																																																																																																																																																																																																																																																																																																																																																																																																																																																
231/C4	7																																																																																																																																																																																																																																																																																																																																																																																																																																																																
231/C4	8																																																																																																																																																																																																																																																																																																																																																																																																																																																																
231/A7	9																																																																																																																																																																																																																																																																																																																																																																																																																																																																
231/C5	10																																																																																																																																																																																																																																																																																																																																																																																																																																																																
231/A8	11																																																																																																																																																																																																																																																																																																																																																																																																																																																																
231/C6	12																																																																																																																																																																																																																																																																																																																																																																																																																																																																
231/C7	13																																																																																																																																																																																																																																																																																																																																																																																																																																																																
231/C7	14																																																																																																																																																																																																																																																																																																																																																																																																																																																																
231/A9	15																																																																																																																																																																																																																																																																																																																																																																																																																																																																
231/C10	16																																																																																																																																																																																																																																																																																																																																																																																																																																																																
232/A2	17																																																																																																																																																																																																																																																																																																																																																																																																																																																																
232/A2	18																																																																																																																																																																																																																																																																																																																																																																																																																																																																
232/A3	19																																																																																																																																																																																																																																																																																																																																																																																																																																																																
232/A4	20																																																																																																																																																																																																																																																																																																																																																																																																																																																																
232/C2	21																																																																																																																																																																																																																																																																																																																																																																																																																																																																
232/C4	22																																																																																																																																																																																																																																																																																																																																																																																																																																																																
SPARE	23																																																																																																																																																																																																																																																																																																																																																																																																																																																																
232/C4	24																																																																																																																																																																																																																																																																																																																																																																																																																																																																
232/C4	25																																																																																																																																																																																																																																																																																																																																																																																																																																																																
232/C4	26																																																																																																																																																																																																																																																																																																																																																																																																																																																																
232/B7	27																																																																																																																																																																																																																																																																																																																																																																																																																																																																
232/E7	28																																																																																																																																																																																																																																																																																																																																																																																																																																																																
232/B8	29																																																																																																																																																																																																																																																																																																																																																																																																																																																																
232/E8	30																																																																																																																																																																																																																																																																																																																																																																																																																																																																
233/E4	31																																																																																																																																																																																																																																																																																																																																																																																																																																																																
233/E5	32																																																																																																																																																																																																																																																																																																																																																																																																																																																																
233/E6	33																																																																																																																																																																																																																																																																																																																																																																																																																																																																
233/E7	34																																																																																																																																																																																																																																																																																																																																																																																																																																																																
SPARE	35																																																																																																																																																																																																																																																																																																																																																																																																																																																																
SPARE	36																																																																																																																																																																																																																																																																																																																																																																																																																																																																
SPARE	37																																																																																																																																																																																																																																																																																																																																																																																																																																																																
SPARE	38																																																																																																																																																																																																																																																																																																																																																																																																																																																																
SPARE	39																																																																																																																																																																																																																																																																																																																																																																																																																																																																
SPARE	40																																																																																																																																																																																																																																																																																																																																																																																																																																																																
SPARE	41																																																																																																																																																																																																																																																																																																																																																																																																																																																																
SPARE	42																																																																																																																																																																																																																																																																																																																																																																																																																																																																
SPARE	43																																																																																																																																																																																																																																																																																																																																																																																																																																																																
SPARE	44																																																																																																																																																																																																																																																																																																																																																																																																																																																																
SPARE	45																																																																																																																																																																																																																																																																																																																																																																																																																																																																
SPARE	46																																																																																																																																																																																																																																																																																																																																																																																																																																																																
SPARE	47																																																																																																																																																																																																																																																																																																																																																																																																																																																																
SPARE	48																																																																																																																																																																																																																																																																																																																																																																																																																																																																
SPARE	49																																																																																																																																																																																																																																																																																																																																																																																																																																																																
SPARE	50																																																																																																																																																																																																																																																																																																																																																																																																																																																																
REFERENCE	X3 AC CKT.																																																																																																																																																																																																																																																																																																																																																																																																																																																																
211/A3	1																																																																																																																																																																																																																																																																																																																																																																																																																																																																
211/A7	2																																																																																																																																																																																																																																																																																																																																																																																																																																																																
211/A3	3																																																																																																																																																																																																																																																																																																																																																																																																																																																																
211/A7	4																																																																																																																																																																																																																																																																																																																																																																																																																																																																
211/B3	5																																																																																																																																																																																																																																																																																																																																																																																																																																																																
211/B7	6																																																																																																																																																																																																																																																																																																																																																																																																																																																																
211/B3	7																																																																																																																																																																																																																																																																																																																																																																																																																																																																
211/B7	8																																																																																																																																																																																																																																																																																																																																																																																																																																																																
SPARE	9																																																																																																																																																																																																																																																																																																																																																																																																																																																																
SPARE	10																																																																																																																																																																																																																																																																																																																																																																																																																																																																
REFERENCE	2X51 CON & PROTIN CKTS.																																																																																																																																																																																																																																																																																																																																																																																																																																																																
237/A3	1																																																																																																																																																																																																																																																																																																																																																																																																																																																																
237/C2	2																																																																																																																																																																																																																																																																																																																																																																																																																																																																
237/C3	3																																																																																																																																																																																																																																																																																																																																																																																																																																																																
237/C4	4																																																																																																																																																																																																																																																																																																																																																																																																																																																																
237/C3	5																																																																																																																																																																																																																																																																																																																																																																																																																																																																
237/C4	6																																																																																																																																																																																																																																																																																																																																																																																																																																																																
237/C4	7																																																																																																																																																																																																																																																																																																																																																																																																																																																																
237/C4	8																																																																																																																																																																																																																																																																																																																																																																																																																																																																
237/A7	9																																																																																																																																																																																																																																																																																																																																																																																																																																																																
237/C5	10																																																																																																																																																																																																																																																																																																																																																																																																																																																																
237/A8	11																																																																																																																																																																																																																																																																																																																																																																																																																																																																
237/C6	12																																																																																																																																																																																																																																																																																																																																																																																																																																																																
237/C7	13																																																																																																																																																																																																																																																																																																																																																																																																																																																																
237/C7	14																																																																																																																																																																																																																																																																																																																																																																																																																																																																
237/A9	15																																																																																																																																																																																																																																																																																																																																																																																																																																																																
237/C10	16																																																																																																																																																																																																																																																																																																																																																																																																																																																																
235/A2	17																																																																																																																																																																																																																																																																																																																																																																																																																																																																
235/A2	18																																																																																																																																																																																																																																																																																																																																																																																																																																																																
235/A3	19																																																																																																																																																																																																																																																																																																																																																																																																																																																																
235/A4	20																																																																																																																																																																																																																																																																																																																																																																																																																																																																
235/C2	21																																																																																																																																																																																																																																																																																																																																																																																																																																																																
235/C4	22																																																																																																																																																																																																																																																																																																																																																																																																																																																																
235/C4	23																																																																																																																																																																																																																																																																																																																																																																																																																																																																
SPARE	24																																																																																																																																																																																																																																																																																																																																																																																																																																																																
SPARE	25																																																																																																																																																																																																																																																																																																																																																																																																																																																																
236/A3	26																																																																																																																																																																																																																																																																																																																																																																																																																																																																
236/A6	27																																																																																																																																																																																																																																																																																																																																																																																																																																																																
236/A8	28																																																																																																																																																																																																																																																																																																																																																																																																																																																																
236/A9	29																																																																																																																																																																																																																																																																																																																																																																																																																																																																
236/C3	30																																																																																																																																																																																																																																																																																																																																																																																																																																																																
236/C3	31																																																																																																																																																																																																																																																																																																																																																																																																																																																																
236/C4	32																																																																																																																																																																																																																																																																																																																																																																																																																																																																
236/C4	33																																																																																																																																																																																																																																																																																																																																																																																																																																																																
236/C5	34																																																																																																																																																																																																																																																																																																																																																																																																																																																																
236/C5	35																																																																																																																																																																																																																																																																																																																																																																																																																																																																
236/C6	36																																																																																																																																																																																																																																																																																																																																																																																																																																																																
236/C6	37																																																																																																																																																																																																																																																																																																																																																																																																																																																																
236/C7	38																																																																																																																																																																																																																																																																																																																																																																																																																																																																
236/C8	39																																																																																																																																																																																																																																																																																																																																																																																																																																																																
236/C9	40																																																																																																																																																																																																																																																																																																																																																																																																																																																																
236/C9	41																																																																																																																																																																																																																																																																																																																																																																																																																																																																
237/A2	42																																																																																																																																																																																																																																																																																																																																																																																																																																																																
237/A2	43																																																																																																																																																																																																																																																																																																																																																																																																																																																																
237/A3	44																																																																																																																																																																																																																																																																																																																																																																																																																																																																
237/A4	45																																																																																																																																																																																																																																																																																																																																																																																																																																																																
237/D2	46																																																																																																																																																																																																																																																																																																																																																																																																																																																																
237/D4	47																																																																																																																																																																																																																																																																																																																																																																																																																																																																
237/D5	48																																																																																																																																																																																																																																																																																																																																																																																																																																																																
237/A8	49																																																																																																																																																																																																																																																																																																																																																																																																																																																																
237/F8	50																																																																																																																																																																																																																																																																																																																																																																																																																																																																
REFERENCE	2X51 CON & PROTIN CKTS.																																																																																																																																																																																																																																																																																																																																																																																																																																																																
237/B8	51																																																																																																																																																																																																																																																																																																																																																																																																																																																																
237/F8	52																																																																																																																																																																																																																																																																																																																																																																																																																																																																
SPARE	53																																																																																																																																																																																																																																																																																																																																																																																																																																																																
SPARE	54																																																																																																																																																																																																																																																																																																																																																																																																																																																																
238/E4	55																																																																																																																																																																																																																																																																																																																																																																																																																																																																
238/E5	56																																																																																																																																																																																																																																																																																																																																																																																																																																																																
238/E6	57																																																																																																																																																																																																																																																																																																																																																																																																																																																																
238/E7	58																																																																																																																																																																																																																																																																																																																																																																																																																																																																
SPARE	59																																																																																																																																																																																																																																																																																																																																																																																																																																																																
SPARE	60																																																																																																																																																																																																																																																																																																																																																																																																																																																																
SPARE	61																																																																																																																																																																																																																																																																																																																																																																																																																																																																
SPARE	62																																																																																																																																																																																																																																																																																																																																																																																																																																																																
SPARE	63																																																																																																																																																																																																																																																																																																																																																																																																																																																																
SPARE	64																																																																																																																																																																																																																																																																																																																																																																																																																																																																
SPARE	65																																																																																																																																																																																																																																																																																																																																																																																																																																																																
SPARE	66																																																																																																																																																																																																																																																																																																																																																																																																																																																																
SPARE	67																																																																																																																																																																																																																																																																																																																																																																																																																																																																
SPARE	68																																																																																																																																																																																																																																																																																																																																																																																																																																																																
SPARE	69																																																																																																																																																																																																																																																																																																																																																																																																																																																																
SPARE	70																																																																																																																																																																																																																																																																																																																																																																																																																																																																
SPARE	71																																																																																																																																																																																																																																																																																																																																																																																																																																																																
SPARE	72																																																																																																																																																																																																																																																																																																																																																																																																																																																																
SPARE	73																																																																																																																																																																																																																																																																																																																																																																																																																																																																
SPARE	74																																																																																																																																																																																																																																																																																																																																																																																																																																																																
SPARE	75																																																																																																																																																																																																																																																																																																																																																																																																																																																																
REFERENCE	X4 DC CKTS.																																																																																																																																																																																																																																																																																																																																																																																																																																																																
216/B3	1																																																																																																																																																																																																																																																																																																																																																																																																																																																																
216/B3	2																																																																																																																																																																																																																																																																																																																																																																																																																																																																
216/D3	3																																																																																																																																																																																																																																																																																																																																																																																																																																																																
216/D3	4																																																																																																																																																																																																																																																																																																																																																																																																																																																																
SPARE	5																																																																																																																																																																																																																																																																																																																																																																																																																																																																
SPARE	6																																																																																																																																																																																																																																																																																																																																																																																																																																																																
SPARE	7																																																																																																																																																																																																																																																																																																																																																																																																																																																																
SPARE	8																																																																																																																																																																																																																																																																																																																																																																																																																																																																
SPARE	9																																																																																																																																																																																																																																																																																																																																																																																																																																																																
SPARE	10																																																																																																																																																																																																																																																																																																																																																																																																																																																																
REFERENCE	X61 ALM. CKT.																																																																																																																																																																																																																																																																																																																																																																																																																																																																
212/E5	1																																																																																																																																																																																																																																																																																																																																																																																																																																																																
212/E5	2																																																																																																																																																																																																																																																																																																																																																																																																																																																																
292/E4	3																																																																																																																																																																																																																																																																																																																																																																																																																																																																
292/E5	4																																																																																																																																																																																																																																																																																																																																																																																																																																																																
292/E6	5																																																																																																																																																																																																																																																																																																																																																																																																																																																																
292/E7	6																																																																																																																																																																																																																																																																																																																																																																																																																																																																
292/E7	7																																																																																																																																																																																																																																																																																																																																																																																																																																																																
SPARE	8																																																																																																																																																																																																																																																																																																																																																																																																																																																																
SPARE	9																																																																																																																																																																																																																																																																																																																																																																																																																																																																
SPARE	10																																																																																																																																																																																																																																																																																																																																																																																																																																																																
SPARE	11																																																																																																																																																																																																																																																																																																																																																																																																																																																																
SPARE	12																																																																																																																																																																																																																																																																																																																																																																																																																																																																
SPARE	13																																																																																																																																																																																																																																																																																																																																																																																																																																																																
SPARE	14																																																																																																																																																																																																																																																																																																																																																																																																																																																																
SPARE	15																																																																																																																																																																																																																																																																																																																																																																																																																																																																
REFERENCE	X6 ALM. CKT.																																																																																																																																																																																																																																																																																																																																																																																																																																																																
212/C5	1																																																																																																																																																																																																																																																																																																																																																																																																																																																																
212/C5	2																																																																																																																																																																																																																																																																																																																																																																																																																																																																
292/E3	3																																																																																																																																																																																																																																																																																																																																																																																																																																																																
SPARE	4																																																																																																																																																																																																																																																																																																																																																																																																																																																																
SPARE	5																																																																																																																																																																																																																																																																																																																																																																																																																																																																
REFERENCE	XTJ T.JACK																																																																																																																																																																																																																																																																																																																																																																																																																																																																
211/C3	1																																																																																																																																																																																																																																																																																																																																																																																																																																																																
211/D3	2																																																																																																																																																																																																																																																																																																																																																																																																																																																																
211/D3	3																																																																																																																																																																																																																																																																																																																																																																																																																																																																
211/D3	4																																																																																																																																																																																																																																																																																																																																																																																																																																																																
SPARE	5																																																																																																																																																																																																																																																																																																																																																																																																																																																																
REFERENCE	XSH SPACE HEATER																																																																																																																																																																																																																																																																																																																																																																																																																																																																
211/E6	1																																																																																																																																																																																																																																																																																																																																																																																																																																																																
211/F6	2																																																																																																																																																																																																																																																																																																																																																																																																																																																																
SPARE	3																																																																																																																																																																																																																																																																																																																																																																																																																																																																
B																																																																																																																																																																																																																																																																																																																																																																																																																																																																	
C																																																																																																																																																																																																																																																																																																																																																																																																																																																																	
D																																																																																																																																																																																																																																																																																																																																																																																																																																																																	
E																																																																																																																																																																																																																																																																																																																																																																																																																																																																	
F																																																																																																																																																																																																																																																																																																																																																																																																																																																																	
G	<table border="1" style="width:100%; border-collapse: collapse;"> <tr> <td colspan="3">AS-BUILT BY _____ DATE _____</td> <td colspan="2">CONTRACT NO. 11131113/00</td> <td colspan="2">JOB ORDER NO. S-13656</td> <td colspan="3" style="text-align: center;"> TERMINAL BLOCKS +BB2-3 132KV BUSBAR PROTIN.MAIN-2 BU PANEL +BBP2-3 S/S 8709 - 132/13.8KV IN AL-KHARJ CITY RIYADH SAUDI ARABIA </td> </tr> <tr> <td colspan="3">DRAWN BY RIZ CHECKED BY KVR</td> <td colspan="2">DATE STARTED 30.01.2013</td> <td colspan="2">DATE COMPLETED</td> <td colspan="3">INDEX PLANT NO. DRAWING NUMBER</td> </tr> <tr> <td colspan="3">FOR APPROVAL</td> <td colspan="2">OPRG. DEPT. CTPD</td> <td colspan="2">ENG. DEPT. AUT-PSAC</td> <td colspan="3">SHEET NO. REV. NO.</td> </tr> <tr> <td>REV. NO.</td> <td>DATE</td> <td>DESCRIPTION</td> <td colspan="2"></td> <td colspan="2"></td> <td colspan="3"></td> </tr> </table>										AS-BUILT BY _____ DATE _____			CONTRACT NO. 11131113/00		JOB ORDER NO. S-13656		TERMINAL BLOCKS +BB2-3 132KV BUSBAR PROTIN.MAIN-2 BU PANEL +BBP2-3 S/S 8709 - 132/13.8KV IN AL-KHARJ CITY RIYADH SAUDI ARABIA			DRAWN BY RIZ CHECKED BY KVR			DATE STARTED 30.01.2013		DATE COMPLETED		INDEX PLANT NO. DRAWING NUMBER			FOR APPROVAL			OPRG. DEPT. CTPD		ENG. DEPT. AUT-PSAC		SHEET NO. REV. NO.			REV. NO.	DATE	DESCRIPTION																																																																																																																																																																																																																																																																																																																																																																																																																						
AS-BUILT BY _____ DATE _____			CONTRACT NO. 11131113/00		JOB ORDER NO. S-13656		TERMINAL BLOCKS +BB2-3 132KV BUSBAR PROTIN.MAIN-2 BU PANEL +BBP2-3 S/S 8709 - 132/13.8KV IN AL-KHARJ CITY RIYADH SAUDI ARABIA																																																																																																																																																																																																																																																																																																																																																																																																																																																										
DRAWN BY RIZ CHECKED BY KVR			DATE STARTED 30.01.2013		DATE COMPLETED		INDEX PLANT NO. DRAWING NUMBER																																																																																																																																																																																																																																																																																																																																																																																																																																																										
FOR APPROVAL			OPRG. DEPT. CTPD		ENG. DEPT. AUT-PSAC		SHEET NO. REV. NO.																																																																																																																																																																																																																																																																																																																																																																																																																																																										
REV. NO.	DATE	DESCRIPTION																																																																																																																																																																																																																																																																																																																																																																																																																																																															